IREDELL COUNTY HEALTH DEPARTMENT

STATESVILLE 704-878-5305 MOORESVILLE 704-664-5281

IMPROVEMENT PERMIT / AUTHORIZATION TO CONSTRUCT / OPERATION PERMIT / EXISTING SYSTEM INSPECTION

PERMIT# 91373 PIN# 4787 65 4073 DATE 9-14-00

OWNER OR CONTRACTOR Acorn Development Inc PHONE: Business 872 0092 Home --

ADDRESS PO Box 5671 Statesville N.C.

LOCATION 64E TL Garden Valley TL Lasser Head TR Barriere circle

SUBDIVISION Cool Spring MHP BLOCK / SECTION LOT 14 LOT AREA 3.88 acres SITE CLASS PS DESIGN FLOW 360 L.T.A.R. .3

Septic Tank: 1000 Gallons: STB 1012 Date 6-28-00
Pump Tank: Gallons: PT Date
Pump Make: Model Serial No
Nitrification Field: No Fields 1 Square Feet 900 Linear Feet 300
No Lines 4 Trench Width 36" Max Trench Bottom Depth 36" Gravel Depth N/A

☑ New System ☐ Repair System Type: I, II, III, IV, V, VI
System Description: Gravity 25% Reduction
Repair System Description: Pump To 50%
Maintenance Agreement Required: Yes No


☐ House/Mod. Home No. Bedrooms 3
☑ Mobile Home No. Bathrooms 2
☐ Business No. Employees
☐ Other
☐ Slab ☑ Crawl Space ☐ Basement w/plumbing ☐ Basement wo/plumbing

Water Supply: ☐ Individual ☐ Public ☑ Community

Comments/Conditions:

Comments/Conditions: SEPTIC TANK W/ MARKER
INSPACED USING "POLYLOK" FILTER

INITIAL SITE SKETCH

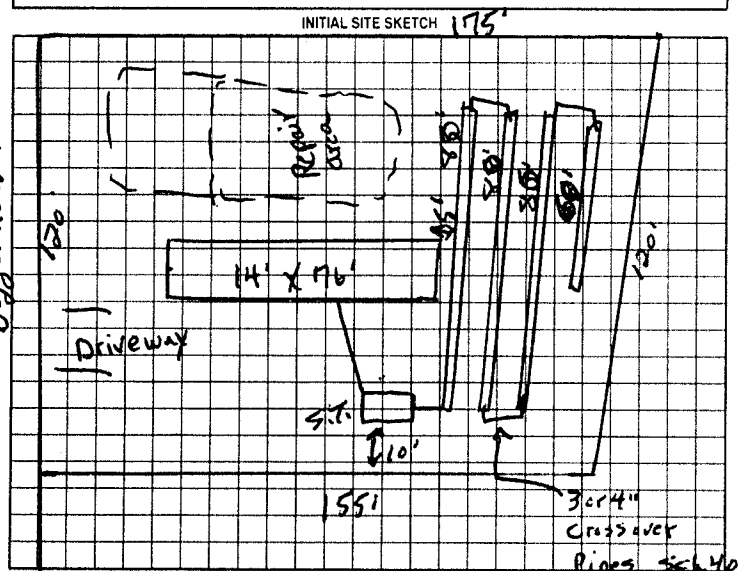

AS BUILT SKETCH

SYSTEM INSTALLED USING THIRTY (30') HDS SECTIONS ACCORDING TO INITAL SITE SKETCH. SYSTEM INSTALLED OVER EXISTING CONVENTIONAL DRAWLINES RUNNING LENGTH WISE WITH NEW SYSTEM

Permit can be suspended or revoked if any false information is supplied toward securing the permit/any unauthorized changes are made to the site/any unauthorized changes are made in the installation of the system. Improvement Permit with plat valid without expiration. Improvement Permit with site plan valid for sixty months. Authorization to Construct is valid for a period equal to that of Improvement Permit - not to exceed sixty months.

Signed: Tom White date

Improvement Permit by: P.C. Moore date 9-14-00

Authorization to Construct by: P.C. Moore date 9-14-00

Installed by: TOMMY FRYE

Operation Permit by: STEVE HENDRICK date 11-15-00

Existing System Inspection by: date

HEALTH DEPT COPY WHITE OWNER COPY (FINAL) YELLOW OWNER COPY (INITIAL) PINK