IREDELL COUNTY HEALTH DEPARTMENT

STATESVILLE 704-878-5305 MOORESVILLE 704-664-5281

IMPROVEMENT PERMIT / AUTHORIZATION TO CONSTRUCT / OPERATION PERMIT / EXISTING SYSTEM INSPECTION

PERMIT# Repair PIN#

OWNER OR CONTRACTOR Michael White PHONE: Business Pager 924-4916 Home DATE 4-22-99

ADDRESS Acorn Dev.

LOCATION L4E @ TL Coolsprings Rd TR Longer Head TL Barriere 1st Trailer on (L)

SUBDIVISION Coolsprings MHP BLOCK / SECTION LOT #3 LOT AREA SITE CLASS. P/S DESIGN FLOW P/S L.T.A.R. 0.3

Septic Tank: 1000G Ex. Gallons; STB Date

Pump Tank: Gallons; PT Date

Pump Make: Model Serial No.

Nitrification Field: No Fields 1 Square Feet 630 Linear Feet 210

No Lines 3 Trench Width 36 Max Trench Bottom Depth 36 Gravel Depth 12in

☐ New System ☒ Repair System Type: I (II) III. IV. V. VI

System Description:

Repair System Description: Gravity Conventional

Maintenance Agreement Required: ☐ Yes ☐ No

☐ Slab ☒ Crawl Space ☐ Basement w/plumbing ☐ Basement wo/plumbing

☐ House/Mod. Home No. Bedrooms 3

☒ Mobile Home No. Bathrooms 2

☐ Business No. Employees

☐ Other


Water Supply: ☐ Individual ☐ Public ☒ Community well

Comments/Conditions: Need to smooth out for lines (Trees) Stumps


This permit serves as 'Notice of Violation.

Comments/Conditions:

INITIAL SITE SKETCH

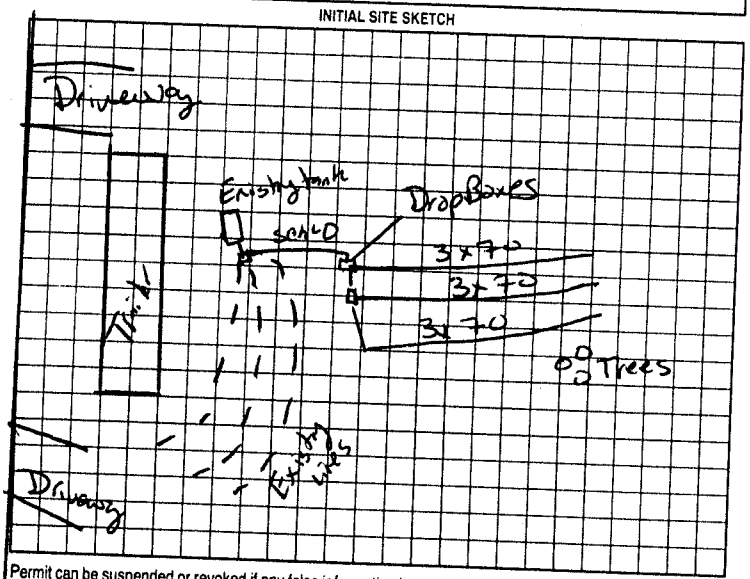

AS BUILT SKETCH

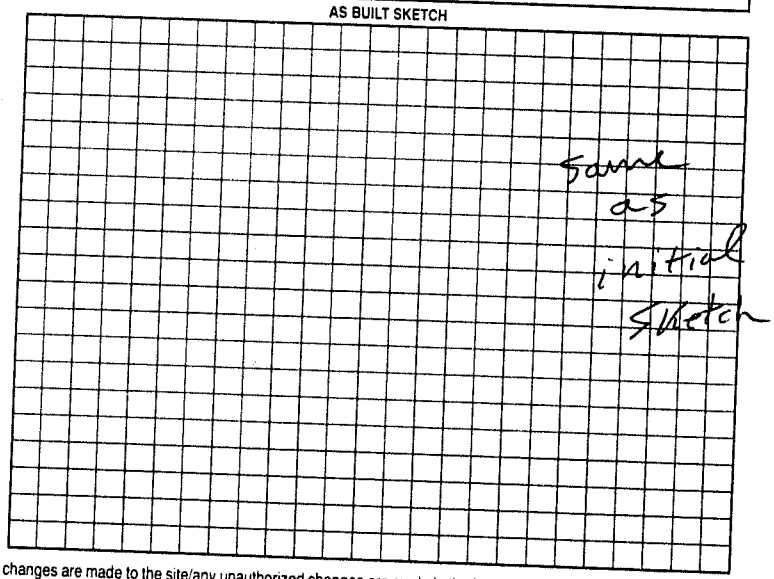

Permit can be suspended or revoked if any false information is supplied toward securing the permit/any unauthorized changes are made to the site/any unauthorized changes are made in the installation of the system. Improvement Permit with plat valid without expiration. Improvement Permit with site plan valid for sixty months. Authorization to Construct is valid for a period equal to that of Improvement Permit – not to exceed sixty months.

Signed: date

Improvement Permit by: Mark Cox RS date 4-22-99

Authorization to Construct by: Mark Cox RS date 4-22-99

Installed by: Barry Sigmon Const.

Operation Permit by: L. C. Moore date 5-24-99

Existing System Inspection by: date

HEALTH DEPT COPY: WHITE OWNER COPY (FINAL) YELLOW OWNER COPY (INITIAL) PINK