IREDELL COUNTY HEALTH DEPARTMENT

STATESVILLE 704-878-5305 MOORESVILLE 704-664-5281

IMPROVEMENT PERMIT / AUTHORIZATION TO CONSTRUCT / OPERATION PERMIT / EXISTING SYSTEM INSPECTION

PERMIT# 107918 PIN# 4787-85-4073.12 DATE 08-12-02

OWNER OR CONTRACTOR ALCORN DEVELOPMENT PHONE: Business 704-924-4916 Home

ADDRESS PO BOX 5671 STATESVILLE, NC 28687

LOCATION 64 E, (L) COOLSPRINGS RD, (R) LOGGERHEAD, (L) COOL SPR6 MHP, GO AROUND CIRCLE LOT # 12 GO LFT.

SUBDIVISION COOL SPRINGS MHP BLOCK / SECTION LOT 12 LOT AREA SITE CLASS DESIGN FLOW 360 L.T.A.R. .4

EASTPIN

Septic Tank: 1000 Gallons: STB 358 Date 4-29-93
Pump Tank: Gallons: PT Date
Pump Make: Model Serial No.
Nitrification Field: No Fields 1 Square Feet 900' Linear Feet 300'
No Lines 3 Trench Width 36" Max Trench Bottom Depth 24" Gravel Depth 12"

☐ New System ☐ Repair System Type: I (II) III IV V VI
System Description: CONV GRAV
Repair System Description:
Maintenance Agreement Required: ☐ Yes ☒ No
☐ Slab ☐ Crawl Space ☐ Basement w/plumbing ☐ Basement wo/plumbing


☐ House/Mod. Home No. Bedrooms 3
☒ Mobile Home No. Bathrooms 2
☐ Business No. Employees
☐ Other

Water Supply:
☐ Individual
☐ Public
☒ Community
SHARED


Comments:/Conditions:

Comments:/Conditions (1) NEW HOME NOT IN PLACE AT TIME OF CHECK (2) MAINTAIN PROPER SETBACKS (3) NO SIGNS OF FAILURE AT TIME OF CHECK.

INITIAL SITE SKETCH

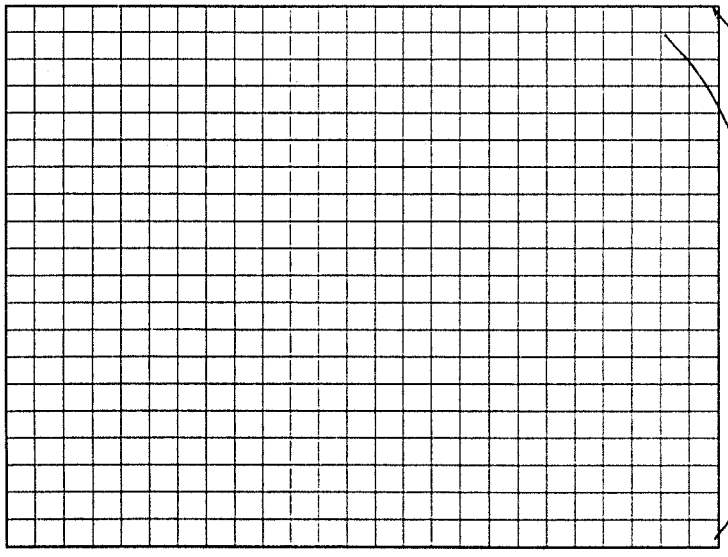

AS BUILT SKETCH

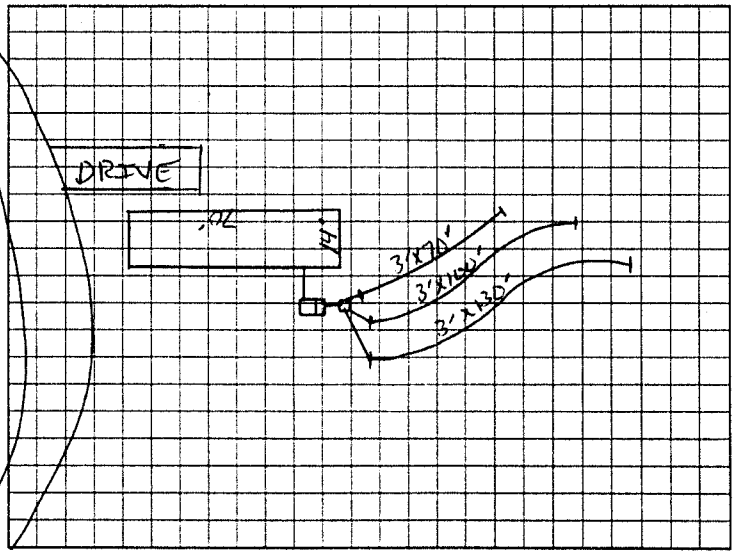

Permit can be suspended or revoked if any false information is supplied toward securing the permit/any unauthorized changes are made to the site any unauthorized changes are made in the installation of the system. Improvement Permit with plat valid without expiration. Improvement Permit with site plan valid for sixty months. Authorization to Construct is valid for a period equal to that of Improvement Permit – not to exceed sixty months

Signed: date 8/27/02 installed by A-1 BACKHOE

Improvement Permit by: date Operation Permit by: date

Authorization to Construct by: date Existing System Inspection by: date 08-12-02

HEALTH DEPT COPY: WHITE OWNER COPY (FINAL) YELLOW OWNER COPY (INITIAL) PINK