(CI)

IREDELL COUNTY HEALTH DEPARTMENT

STATESVILLE 704-878-5305 MOORESVILLE 704-664-5281

IMPROVEMENT PERMIT / AUTHORIZATION TO CONSTRUCT / OPERATION PERMIT / EXISTING SYSTEM INSPECTION

PERMIT# 19116-55 PIN# 4787-18-5-4073-335 4787-[illegible] 854073 DATE 15 May 07

OWNER OR APPLICANT Caramelo Arellano PHONE: Business _____ Home 878 874-2474

ADDRESS 2718 Cotton Mill St Connelly Springs NC 28612

LOCATION 1st R Cool Spring Rd L Loggerhead Rd Rt on Rt - 335 Loggerhead Rd

SUBDIVISION Cool Spring MHP BLOCK / SECTION _____ LOT 1 LOT AREA ½ AC SITE CLASS: R3 DESIGN FLOW 360 L.T.A.R. 1.8 .5

Septic Tank: 1000 / 2 Gallons; STB _____ Date _____

Pump Tank: _____ Gallons; PT _____ Date _____

Pump Make: _____ Model _____ Serial No. _____

Nitrification Field: No Fields _____ Square Feet 720 Linear Feet 240

No Lines 3 Trench Width 36" Max Trench Bottom Depth 24" Gravel Depth 12" ☐ Gravity ☐ Pressure

☐ New System ☐ Repair ☐ Expansion System Type: I II III IV V VI

System Description: Existing

Repair System Description: _____

Maintenance Agreement Required: ☐ Yes ☐ No

☐ House/Mod. Home ☑ Mobile Home ☐ Business ☐ Other

No. Bedrooms 3 No. Persons 2 No. Employees _____

Water Supply: ☐ Individual ☐ Public ☑ Community


☐ Slab ☑ Crawl Space ☐ Basement w/plumbing ☐ Basement wo/plumbing

Comments/Conditions:

INITIAL SITE SKETCH

Comments/Conditions:

AS BUILT SKETCH

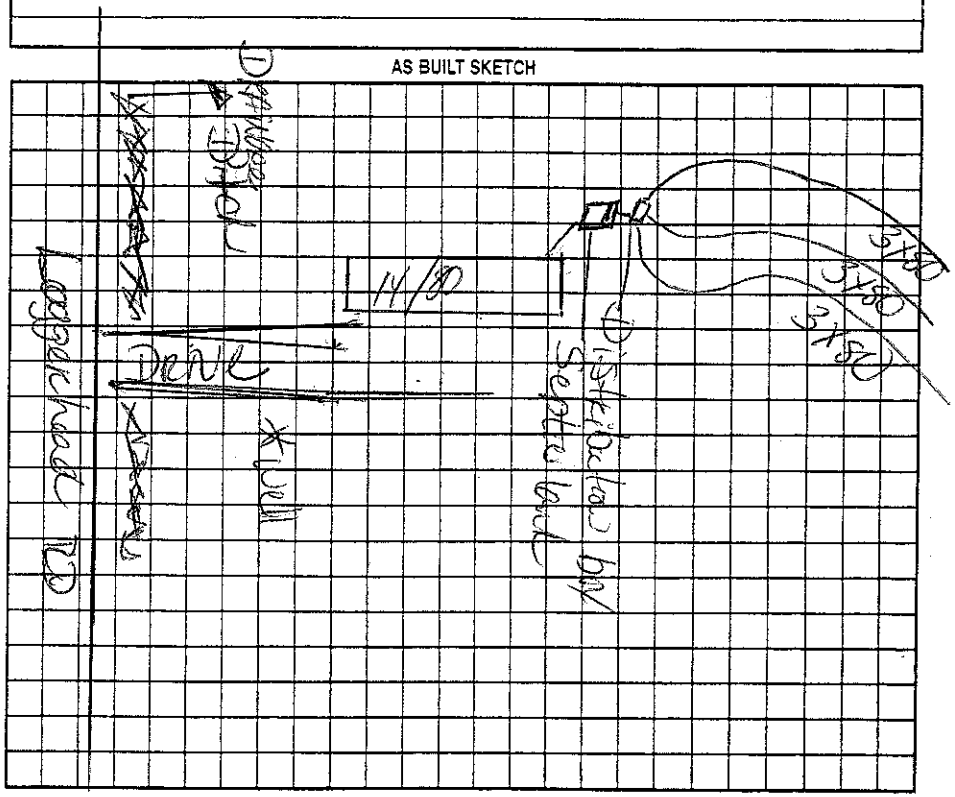

Permit can be suspended or revoked if any false information is supplied toward securing the permit/any unauthorized changes are made to the site/any unauthorized changes are made in the installation of the system. Improvement Permit with plat valid without expiration ☐ Improvement Permit with site plan valid for sixty months ☐ Authorization to Construct is valid for a period equal to that of Improvement Permit – not to exceed sixty months.

Signed: _____ date _____ Installed by: _____

Improvement Permit by: _____ date _____ Operation Permit by: _____ date _____

Authorization to Construct by: _____ date _____ Existing System Inspection by: [signature] date 15 May 07

HEALTH DEPT. COPY: WHITE OWNER COPY (FINAL): YELLOW OWNER COPY (INITIAL): PINK