IREDELL COUNTY HEALTH DEPARTMENT

Statesville Office (704) 878-5305 Mooresville Office (704) 660-3625 PERMIT # 20192

IMPROVEMENT PERMIT / AUTHORIZATION TO CONSTRUCT / OPERATION PERMIT / EXISTING SYSTEM PIN # 4787854073

APPLICANT: Eric Davis APPLICANT ADDRESS: P.O. Box Randleman

SITE ADDRESS: 335 Loggerhead Rd Statesville NC 28625 PHONE: 336-587-5622 ALT. PHONE: N/A

SITE DIRECTIONS: 64E T/L Cool Springs T/R Garden Valley T/L Loggerhead Lot on right

SUBDIVISION: Cobl Springs MHP SECTION: N/A LOT # 1 LOT AREA: N/A DESIGN FLOW: 360 L.T.A.R.: EX


Septic Tank	EX	(gal)	STB	EX	Date	EX	☐ New System	☐ Repair	☐ Expansion	System Type: I (II) III IV V VI	☐ Residence	No. Bedrooms	3	Water Supply
Pump Tank	N/A	(gal)	PT	N/A	Date	N/A	System Description:	Existing			☐ Business	No. Persons	6	☒ Private
Pump Make	N/A	Model		N/A	Serial #	N/A	Repair System Description:				☐ Other	No. Employees		☐ Public
# Nitrification Fields	1	# Lines		3	Linear Ft:	~~EX~~	Maintenance Agreement Required:	☐ YES	☒ NO		☐ Slab	☒ Crawl Space		☐ Community
Trench Width	EX	Max. Trench Bottom Depth		EX	Gravel Depth	EX		☑ GRAVITY	☐ PRESSURE		☐ Basement w/plumbing		☐ Basement w/o plumbing	

Comments / Conditions:

All building foundations must be ≥ 25' from any well and ≥ 5' from any part of STS.

INITIAL SITE SKETCH

AS BUILT SKETCH

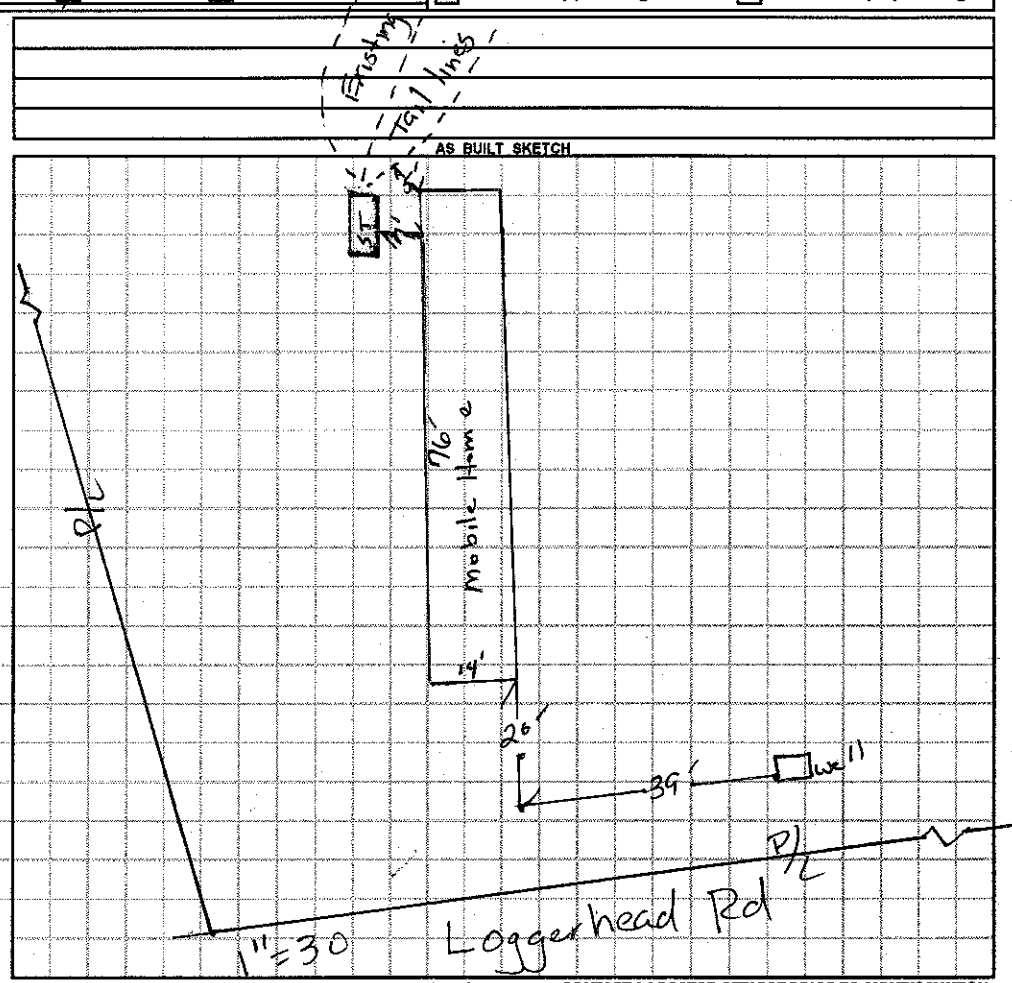

Permit can be suspended or revoked if any false information is supplied toward securing the permit / any unauthorized changes are made to the site / any unauthorized changes are made in the installation of the system. **CONTACT A LOCATOR SERVICE PRIOR TO ANY EXCAVATION**

☐ **IMPROVEMENT PERMIT** *with plat valid without expiration.* ☐ **IMPROVEMENT PERMIT** *with site plan valid for 60 mos.* ☐ **AUTHORIZATION TO CONSTRUCT** *valid for period equal to IMPROVEMENT PERMIT--not to exceed 60 mo.*

Owner / Applicant Signature: [signature] Date: 4-7-14 Installed by:

IMPROVEMENT PERMIT by: Date: OPERATION PERMIT by: Date:

AUTHORIZATION TO CONSTRUCT by: Date: Existing System Inspected by: [signature] Date: 04/03/14

Health Dept. Copy - WHITE Applicant (Final Approval) - YELLOW Applicant (Conditional Approval) - PINK