IREDELL COUNTY HEALTH DEPARTMENT

Statesville Office (704) 878-5305 Mooresville Office (704) 660-3625 PERMIT # 202279

IMPROVEMENT PERMIT / AUTHORIZATION TO CONSTRUCT / OPERATION PERMIT / EXISTING SYSTEM

PIN # 4787854073

APPLICANT: Eric Davis APPLICANT ADDRESS: P.O. Box 452 Randleman NC 27317

SITE ADDRESS: 134 Barrier Cir Statesville NC 28625 PHONE: 336-587-5622 ALT. PHONE: N/A

SITE DIRECTIONS: 64E T/L Cool Springs T/R Garden Valley T/L Eggerhead Rd T/L Barrier Cir.

SUBDIVISION: SECTION: N/A LOT # 11 LOT AREA: N/A DESIGN FLOW: 360 L.T.A.R.: EX


Septic Tank	EX	(gal)	STB	EX	Date	EX	☐ New System	☐ Repair	☐ Expansion	System Type: I (II) III IV V VI	
Pump Tank	N/A	(gal)	PT	N/A	Date	N/A	System Description:	Existing			
Pump Make	N/A	Model	N/A		Serial #	N/A	Repair System Description:				
# Nitrification Fields		# Lines	3		Linear Ft:	EX	Maintenance Agreement Required:	☐ YES	☒ NO		
Trench Width	EX	Max. Trench Bottom Depth	EX		Gravel Depth	EX	☒ GRAVITY	☐ PRESSURE			

☐ Residence	No. Bedrooms	3	Water Supply	
☐ Business	No. Persons	6	☒ Private	
☐ Other	No. Employees		☐ Public	
☐ Slab	☒ Crawl Space		☐ Community	
☐ Basement w/plumbing			☐ Basement w/o plumbing	

Comments / Conditions: All building foundations must be ≥ 25' From any well and ≥ 5' from any part of STS.

INITIAL SITE SKETCH

AS BUILT SKETCH

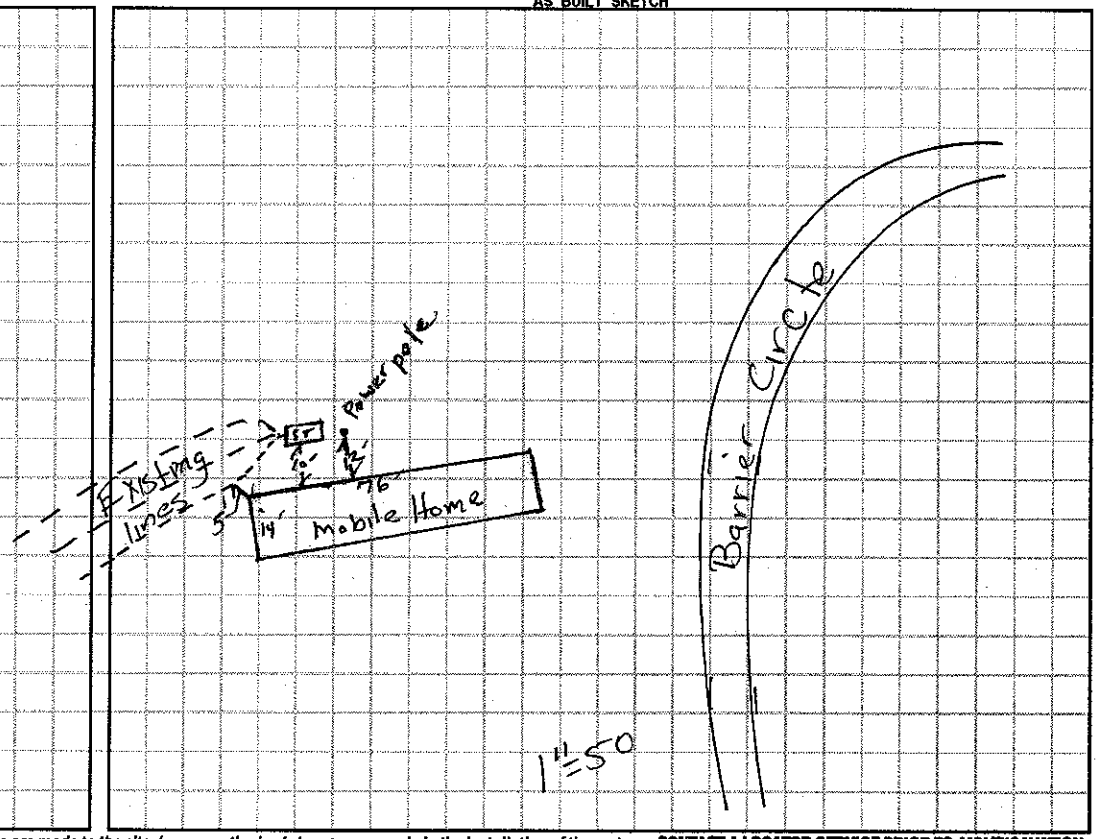

Permit can be suspended or revoked if any false information is supplied toward securing the permit / any unauthorized changes are made to the site / any unauthorized changes are made in the installation of the system. **CONTACT A LOCATOR SERVICE PRIOR TO ANY EXCAVATION**

☐ **IMPROVEMENT PERMIT** *with plat valid without expiration.* ☐ **IMPROVEMENT PERMIT** *with site plan valid for 60 mos.* ☐ **AUTHORIZATION TO CONSTRUCT** *valid for period equal to IMPROVEMENT PERMIT--not to exceed 60 mo.*

Owner / Applicant Signature: [signature] Date: 4-1-14 Installed by:

IMPROVEMENT PERMIT by: Date: OPERATION PERMIT by: Date:

AUTHORIZATION TO CONSTRUCT by: Date: Existing System Inspected by: [signature] Date: 03/04/14

Health Dept. Copy - WHITE Applicant (Final Approval) - YELLOW Applicant (Conditional Approval) - PINK