...LL COUNTY HEALTH DEPARTMENT

Statesville Office (704) 878-5305 Mooresville Office (704) 660-3625 PERMIT # 201914

...MPROVEMENT PERMIT / AUTHORIZATION TO CONSTRUCT / OPERATION PERMIT / EXISTING SYSTEM

PIN # 4787854073

...PLICANT: Eric Davis APPLICANT ADDRESS: P.O. Box 452 Randleman NC 27317

SITE ADDRESS: 114 Barrier Cir Statesville NC PHONE: 336-587-5622 ALT. PHONE: N/A

SITE DIRECTIONS: Cool Springs. to Garden Valley to Loggerhead to Barrier Cir

SUBDIVISION: N/A SECTION: N/A LOT # 5 LOT AREA: DESIGN FLOW: 360 L.T.A.R.: EX

Septic Tank	EX (gal)	STB	EX	Date	EX	☐ New System ☐ Repair ☐ Expansion	System Type: I (II) III IV V VI
Pump Tank	N/A (gal)	PT	N/A	Date	N/A	System Description:	Existing
Pump Make	N/A	Model	N/A	Serial #	N/A	Repair System Description:	Existing
# Nitrification Fields	1	# Lines	EX	Linear Ft:	EX	Maintenance Agreement Required:	☐ YES ☒ NO
Trench Width	EX	Max. Trench Bottom Depth	EX	Gravel Depth	EX	☑ GRAVITY	☐ PRESSURE

☒ Residence ☐ Business ☐ Other ☐ Slab ☐ Basement w/plumbing

No. Bedrooms 3 No. Persons ___ No. Employees ___ ☒ Crawl Space


Water Supply: ☐ Private ☐ Public ☑ Community ☐ Basement w/o plumbing

Comments / Conditions:

All building foundations must be 55' from any part of STS.

INITIAL SITE SKETCH

AS BUILT SKETCH

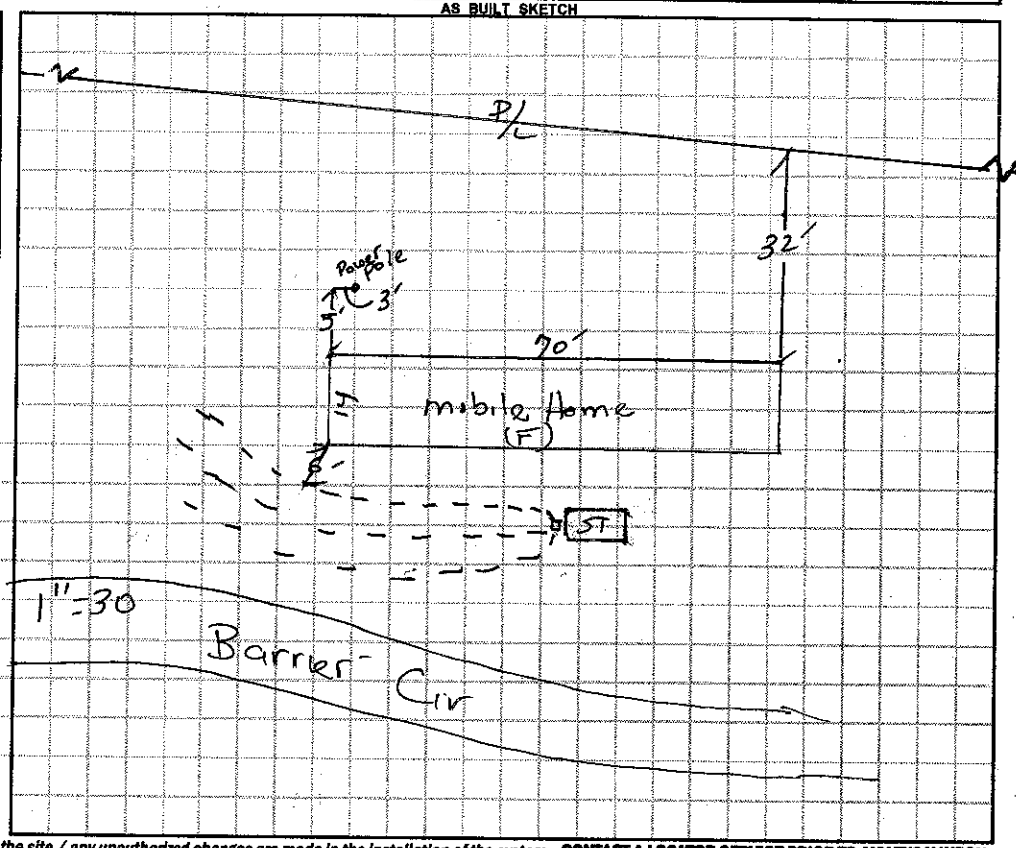

Permit can be suspended or revoked if any false information is supplied toward securing the permit / any unauthorized changes are made to the site / any unauthorized changes are made in the installation of the system. **CONTACT A LOCATOR SERVICE PRIOR TO ANY EXCAVATION**

☐ **IMPROVEMENT PERMIT** *with plat valid without expiration.* ☐ **IMPROVEMENT PERMIT** *with site plan valid for 60 mos.* ☐ **AUTHORIZATION TO CONSTRUCT** *valid for period equal to IMPROVEMENT PERMIT--not to exceed 60 mo.*

Owner / Applicant Signature: [signature] Date: 3-24-14 Installed by: ___

IMPROVEMENT PERMIT by: ___ Date: ___ OPERATION PERMIT by: ___ Date: ___

AUTHORIZATION TO CONSTRUCT by: ___ Date: ___ Existing System Inspected by: [signature] Date: 03/24/14

Health Dept. Copy - WHITE Applicant (Final Approval) - YELLOW Applicant (Conditional Approval) - PINK