IREDELL COUNTY HEALTH DEPARTMENT

Statesville Office (704) 878-5305 Mooresville Office (704) 660-3625 PERMIT # 17763

IMPROVEMENT PERMIT / AUTHORIZATION TO CONSTRUCT / OPERATION PERMIT / EXISTING SYSTEM

PIN # 4787895467

APPLICANT: David Simonson APPLICANT ADDRESS: 133 Squeaky Tree Ln.

SITE ADDRESS: 133 Squeaky Tree Ln. PHONE: 704-546-3061 ALT. PHONE: 704-450-7335


SITE DIRECTIONS: Old Mocksville Rd N TR Society Rd TL Sunflower Rd. TR Squeaky Tree Ln.

SUBDIVISION: N/A SECTION: N/A LOT # N/A LOT AREA: 3.0 acres DESIGN FLOW: 480gpd L.T.A.R.: Existing

Septic Tank 1000 (gal)	STB 1000	Date 9-16	☐ New System ☑ Repair ☐ Expansion System Type: I III III IV V VI	☑ Residence	No. Bedrooms 4	Water Supply
Pump Tank (gal)	PT	Date	System Description: TANK	☐ Business	No. Persons	☐ Private
Pump Make	Model	Serial #	Repair System Description:	☐ Other	No. Employees	☐ Public
# Nitrification Fields 1	# Lines 4	Linear Ft: 6X	Maintenance Agreement Required: ☐ YES ☑ NO	☐ Slab	☑ Crawl Space	☐ Community
Trench Width 6X	Max. Trench Bottom Depth 6X	Gravel Depth 6X	☑ GRAVITY ☐ PRESSURE	☐ Basement w/plumbing		☐ Basement w/o plumbing

Comments / Conditions: Pump & crush old septic tank. Set new 1000 gallon septic tank at location shown below & connect to existing drainfield. If new tank will be deeper than 6" use risers to bring within 6" of surface.

INITIAL SITE SKETCH

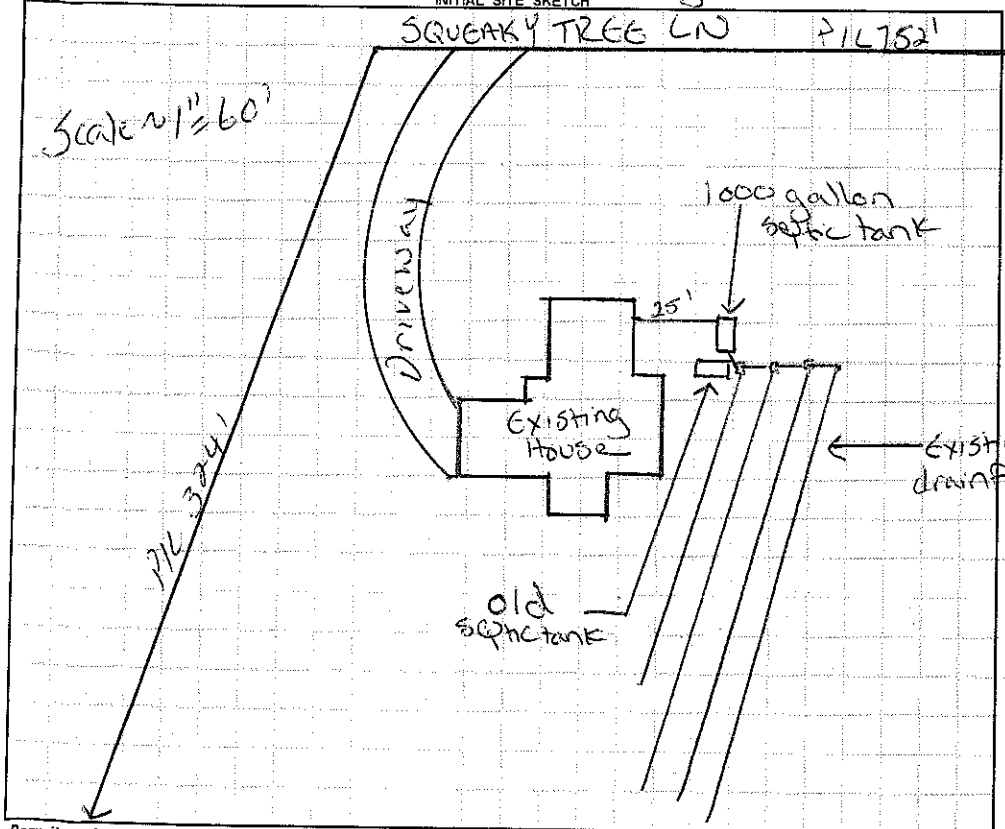

AS BUILT SKETCH

- Red Polylok filter installed
- Plumbing leak noticed @ time of inspection.
- New drop boxes installed due to poor condition of existing drop boxes
- Installed as drawn

Permit can be suspended or revoked if any false information is supplied toward securing the permit / any unauthorized changes are made to the site / any unauthorized changes are made in the installation of the system. **CONTACT A LOCATOR SERVICE PRIOR TO ANY EXCAVATION**

☐ **IMPROVEMENT PERMIT** *with plat* valid without expiration. ☑ **IMPROVEMENT PERMIT** *with site plan* valid for 60 mos. ☑ **AUTHORIZATION TO CONSTRUCT** valid for period equal to IMPROVEMENT PERMIT--not to exceed 60 mo.

Owner / Applicant Signature: David Simonson Date: 3/18/13 Installed by: Lentz Septic

IMPROVEMENT PERMIT by: Justin Henderson Date: 3-18-13 OPERATION PERMIT by: Justin Henderson Date: 3-20-13

AUTHORIZATION TO CONSTRUCT by: Justin Henderson Date: 3-18-13 Existing System Inspected by: Date:

Health Dept. Copy - WHITE Applicant (Final Approval) - YELLOW Applicant (Conditional Approval) - PINK