IREDELL COUNTY HEALTH DEPARTMENT

STATESVILLE 704-878-5305 MOORESVILLE 704-664-5281

IMPROVEMENT PERMIT / AUTHORIZATION TO CONSTRUCT / OPERATION PERMIT / EXISTING SYSTEM INSPECTION

PERMIT# REPAIR PIN# 4787-94-2136 DATE 6-23-06

OWNER OR APPLICANT LEA-WAY FARMS, INC PHONE: Business 704-873-2092 Home 704-880-4500

ADDRESS 417 GARDEN VALLEY ROAD, STATESVILLE NC 28625-9427

LOCATION US 64 EAST, TL COOL SPRINGS ROAD, TR GARDEN VALLEY ROAD, ON LEFT AT LOGGERHEAD ROAD

SUBDIVISION _____ BLOCK / SECTION _____ LOT _____ LOT AREA 9.4 ACRES SITE CLASS. PS' DESIGN FLOW 125 L.T.A.R. 0.25 GPD/FT²

Septic Tank: 1000 Gallons; STB 1012 Date 5-26-06
Pump Tank: _____ Gallons; PT _____ Date _____
Pump Make: _____ Model _____ Serial No. _____
Nitrification Field: No Fields 1 Square Feet 500 Linear Feet 167
No Lines TWO Trench Width 36" Max Trench Bottom Depth 22" Gravel Depth 12"

☑ New System ☐ Repair ☐ Expansion System Type: I (II) III IV V VI
System Description: CONVENTIONAL GRAVITY
Repair System Description: CONVENTIONAL GRAVITY
Maintenance Agreement Required: ☐ Yes ☑ No
☑ Gravity ☐ Pressure


☐ House/Mod. Home No. Bedrooms ____
☐ Mobile Home No. Persons ____
☑ Business No. Employees 5
☐ Other MEAT PROCESSING
☑ Slab ☐ Crawl Space ☐ Basement w/plumbing ☐ Basement wo/plumbing

Water Supply: ☑ Individual ☐ Public ☐ Community WELL


Comments/Conditions ① DISCONNECT DOMESTIC WASTEWATER FROM EXISTING COLLECTION SEWER & TIE INTO NEW SYSTEM ② AN "ACCEPTED" SYSTEM MAY ALSO BE USED ③ INSTALL NEW LINES ON CONTOUR NO DEEPER THAN 22 INCHES DEEP.

Comments/Conditions ④ N.O.V. ISSUED 6-23-06, SYSTEM TO BE REPAIRED BY JULY 24, 2006. ⑤ NO INDUSTRIAL PROCESS WASTEWATER ALLOWED DOMESTIC WASTEWATER ONLY

INITIAL SITE SKETCH

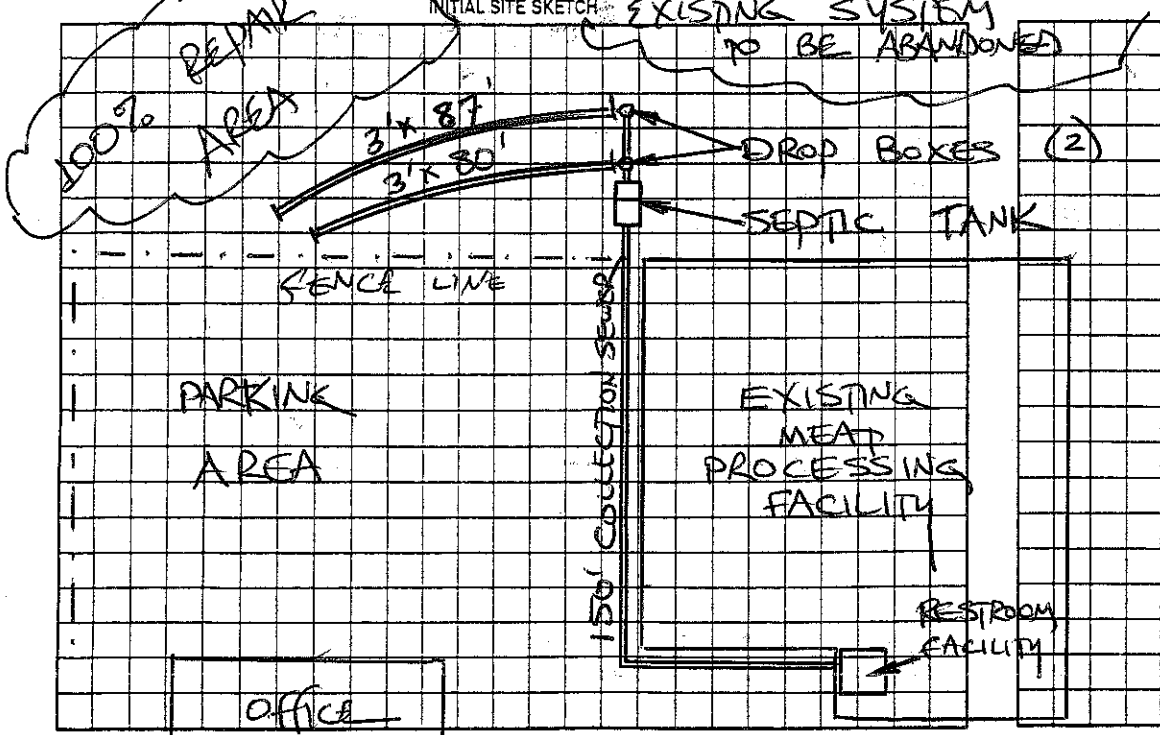

AS BUILT SKETCH

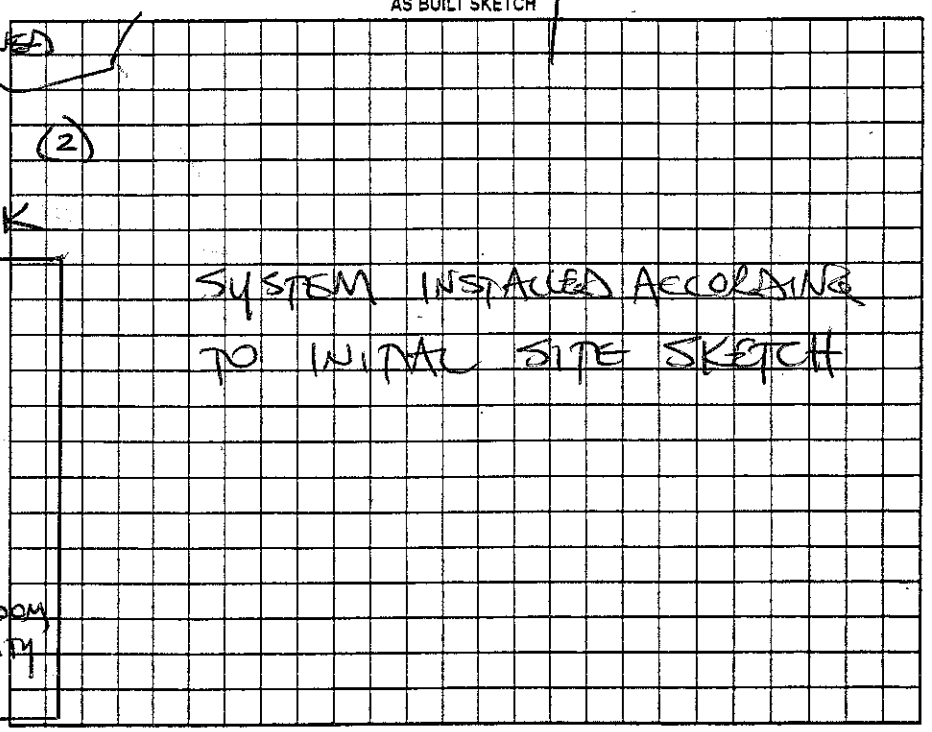

Permit can be suspended or revoked if any false information is supplied toward securing the permit/any unauthorized changes are made to the site/any unauthorized changes are made in the installation of the system. Improvement Permit with plat valid without expiration ☐ Improvement Permit with site plan valid for sixty months ☑ Authorization to Construct is valid for a period equal to that of Improvement Permit – not to exceed sixty months.

Signed: Steven J. Lea date 4/23/06 Installed by: A-1 BACKHOE

Improvement Permit by: STEVE HEDRICK date 6-23-06 Operation Permit by: STEVE HEDRICK date 7-18-06

Authorization to Construct by: STEVE HEDRICK date 6-23-06 Existing System Inspection by: _____ date _____

HEALTH DEPT. COPY: WHITE OWNER COPY (FINAL): YELLOW OWNER COPY (INITIAL): PINK