IREDELL COUNTY HEALTH DEPARTMENT

STATESVILLE 704-878-5305 MOORESVILLE 704-664-5281

IMPROVEMENT PERMIT / AUTHORIZATION TO CONSTRUCT / OPERATION PERMIT / EXISTING SYSTEM INSPECTION

PERMIT# 125419 PIN# 4788-80-2024 7990788 DATE 4-11-05

OWNER OR CONTRACTOR KEVIN MIELKE PHONE: Business Home (704) 546-5911

ADDRESS 376 SUNFLOWER RD. STATESVILLE NC 28625

LOCATION I-40E TL US 64E (EXIT 162) TL SOCIETY CHURCH RD TL SUNFLOWER RD # HOUSE ON RIGHT

SUBDIVISION BLOCK / SECTION LOT LOT AREA SITE CLASS. PS DESIGN FLOW 480 L.T.A.R. 0.30 gpd/ft²

Septic Tank: 1000 Gallons; STB 825 Date 7/15/05
Pump Tank: Gallons; PT Date
Pump Make: Model Serial No.
Nitrification Field: No Fields 1 Square Feet 1600 Linear Feet 540
No Lines 6 Trench Width 36" Max Trench Bottom Depth 36" Gravel Depth 12"


☑ New System ☐ Repair System Type: I, (II) III, IV, V, VI
System Description: CONVENTIONAL GRAVITY
Repair System Description: LP PANEL 50% REDUCTION
Maintenance Agreement Required: ☐ Yes ☑ No

☑ House/Mod. Home No. Bedrooms 4
☐ Mobile Home No. Bathrooms
☐ Business No. Employees
☐ Other
☐ Slab ☐ Crawl Space ☑ Basement w/plumbing ☐ Basement wo/plumbing

Water Supply: ☑ Individual ☐ Public ☐ Community


Comments:/Conditions:
① INSTALL ON CONTOUR
② MAINTAIN WELL & FOUNDATION SETBACKS

INITIAL SITE SKETCH

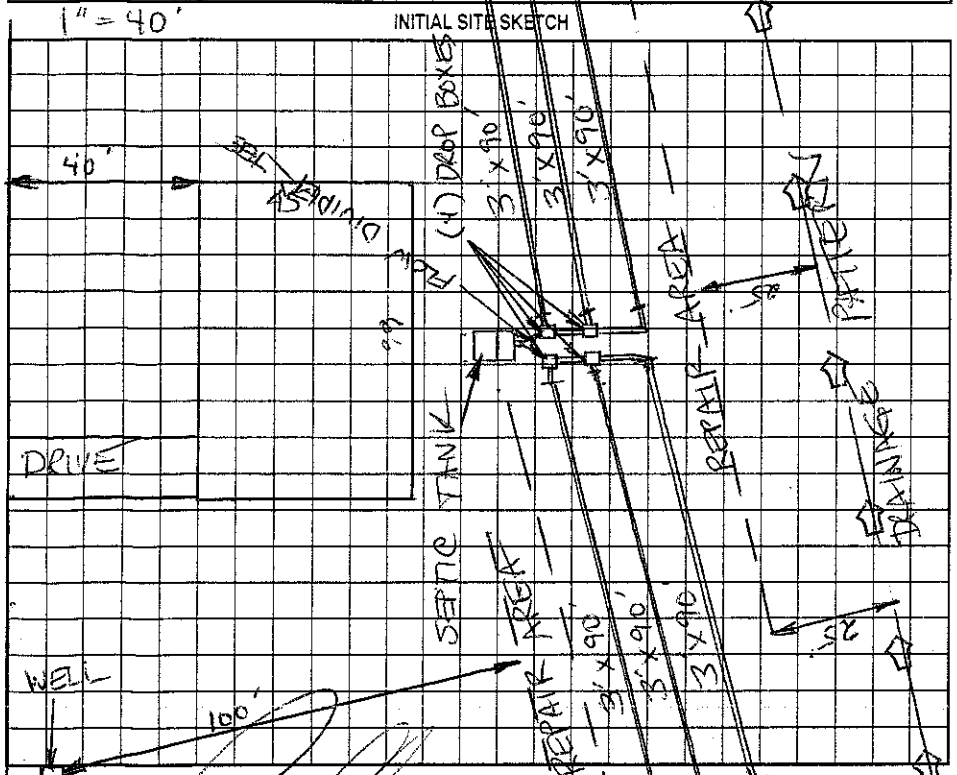

Comments:/Conditions: ST W/RISERS AND TUF-TITE FILTER INSTALLED PUNCH HOLES IN THE WRONG SIDE OF FIRST 2 DROPBOXES, SO TO AVOID REPLACING THEM WE CONNECTED THEM WITH A STRAIGHT PIPE

AS BUILT SKETCH

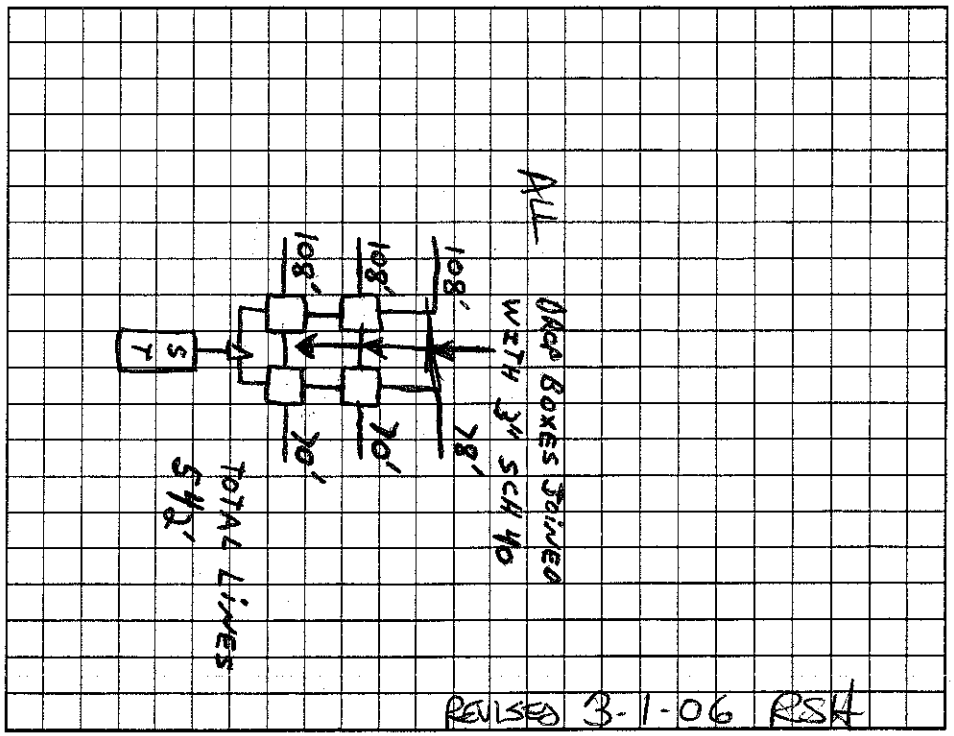

Permit can be suspended or revoked if any false information is supplied toward securing the permit/any unauthorized changes are made to the site/any unauthorized changes are made in the installation of the system. Improvement Permit with plat valid without expiration. Improvement Permit with site plan valid for sixty months. Authorization to Construct is valid for a period equal to that of Improvement Permit – not to exceed sixty months.

Signed: date 4.12.05

Improvement Permit by: CSS date 4-11-05

Authorization to Construct by: CSS date 4-11-05

Installed by: K & K GRADING

Operation Permit by: date 10/3/05

Existing System Inspection by: date

HEALTH DEPT. COPY: WHITE OWNER COPY (FINAL): YELLOW OWNER COPY (INITIAL): PINK