IREDELL COUNTY HEALTH DEPARTMENT

Statesville Office (704) 878-5305 Mooresville Office (704) 660-3625 PERMIT # 179810

IMPROVEMENT PERMIT / AUTHORIZATION TO CONSTRUCT / OPERATION PERMIT / EXISTING SYSTEM

PIN # 4787991916

APPLICANT: Capote Builders APPLICANT ADDRESS: 5426 Capote Rd.

SITE ADDRESS: Sunflower Rd. PHONE: 704-400-5481 ALT. PHONE: N/A

SITE DIRECTIONS: I-40 E to exit #162 TL onto Hwy 64 E TL Ridge Rd. TL Sunflower Rd.


SUBDIVISION: Kevin Mielke SECTION: N/A LOT # 1 LOT AREA: 1.026 acres DESIGN FLOW: 360 gpd. L.T.A.R.: 0.3

Septic Tank	1000 (gal)	STB	760-1000	Date	6-23	☑ New System ☐ Repair ☐ Expansion	System Type: I II ☒ III IV V VI	☒ Residence	No. Bedrooms 3
Pump Tank	(gal)	PT		Date		System Description:	25% Reduction	☐ Business	No. Persons
Pump Make		Model		Serial #		Repair System Description:	Low Pressure PFBPS	☐ Other	No. Employees
# Nitrification Fields	1	# Lines	8	Linear Ft:	300	Maintenance Agreement Required:	☐ YES ☑ NO	☐ Slab	☐ Crawl Space
Trench Width	36"	Max. Trench Bottom Depth	36"	Gravel Depth	N/A	☑ GRAVITY	☐ PRESSURE	☑ Basement w/plumbing	☐ Basement w/o plumbing


Water Supply: ☑ Private ☐ Public ☐ Community

Comments / Conditions: Install a 25% Reduction system on Contour with serial distribution. Back Left Corner (low corner) of building envelope MUST Remain at natural grade.

INITIAL SITE SKETCH

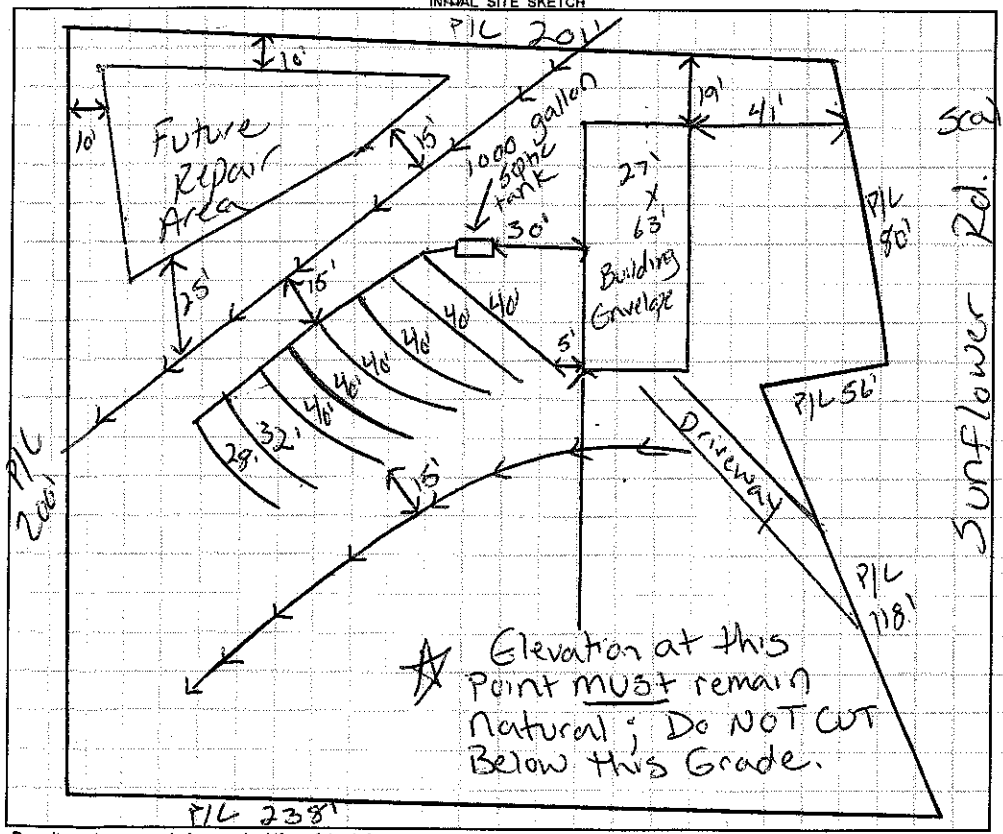

AS BUILT SKETCH

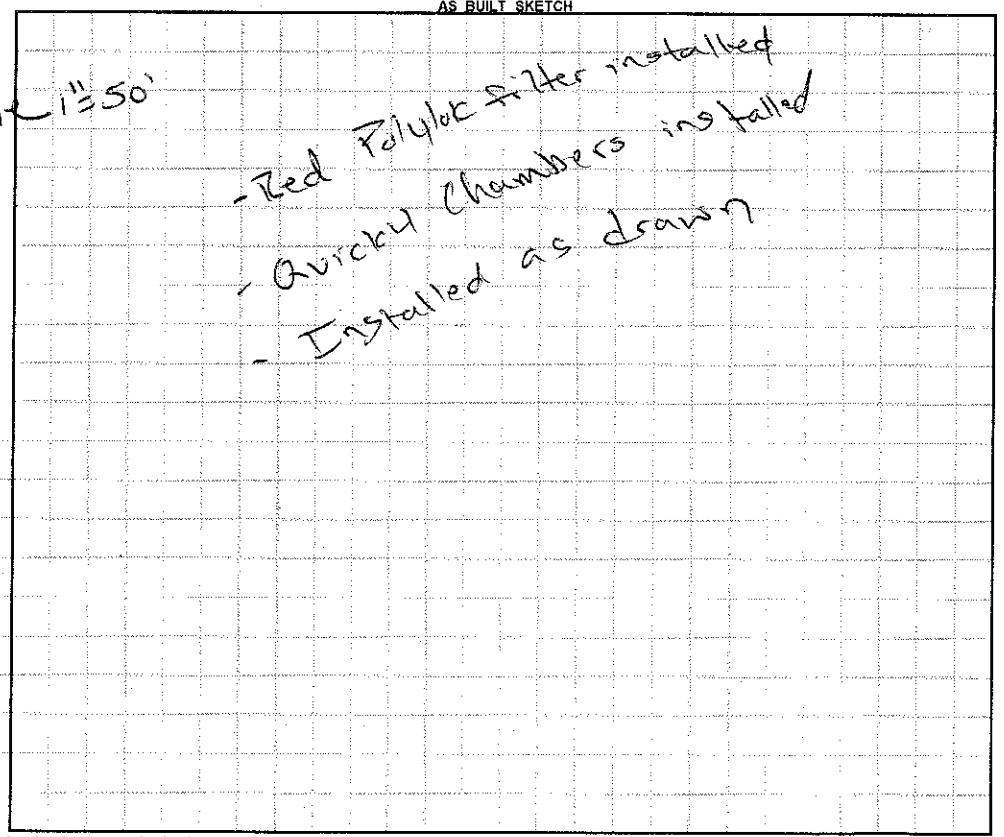

Permit can be suspended or revoked if any false information is supplied toward securing the permit / any unauthorized changes are made to the site / any unauthorized changes are made in the installation of the system. **CONTACT A LOCATOR SERVICE PRIOR TO ANY EXCAVATION**

☐ **IMPROVEMENT PERMIT** ***with plat*** *valid without expiration.* ☑ **IMPROVEMENT PERMIT** ***with site plan*** *valid for 60 mos.* ☑ **AUTHORIZATION TO CONSTRUCT** *valid for period equal to IMPROVEMENT PERMIT--not to exceed 60 mo.*

Owner / Applicant Signature: Brenda Sipe Date: Installed by: Gunter Grading

IMPROVEMENT PERMIT by: Justin Henderson Date: 8-1-13 OPERATION PERMIT by: Justin Henderson Date: 10-30-13

AUTHORIZATION TO CONSTRUCT by: Justin Henderson Date: 8-1-13 Existing System Inspected by: Date:

Health Dept. Copy - WHITE Applicant (Final Approval) - YELLOW Applicant (Conditional Approval) - PINK