IREDELL COUNTY HEALTH DEPARTMENT

STATESVILLE 704-878-5305 (2) 155.00 Paid MOORESVILLE 704-664-5281

IMPROVEMENT PERMIT / AUTHORIZATION TO CONSTRUCT / OPERATION PERMIT / EXISTING SYSTEM INSPECTION

PERMIT# 090583 PIN# ~~4788110941 PT~~ 4788-01-8731 DATE 12/11/02

OWNER OR CONTRACTOR DIXIELAND INC PHONE: Business 828-478-5331 Home

ADDRESS 154 BETHANY RD STATESVILLE NC 28625

LOCATION OLD MOCKSVILLE RD - TR GANTT HORN - ON RT

SUBDIVISION EVANS ACRES BLOCK / SECTION LOT 5 LOT AREA 1.27AC SITE CLASS PS DESIGN FLOW 360GPD L.T.A.R. .36 APP/FT

Septic Tank: 1000 Gallons; STB 825 Date 4-3-03
Pump Tank: Gallons; PT Date
Pump Make: Model Serial No.
Nitrification Field: No Fields 1 Square Feet 900 Linear Feet 500
No Lines 5@60' Trench Width 36" Max Trench Bottom Depth 36" Gravel Depth

☑ New System ☐ Repair System Type: I, II, (III) IV, V, VI
System Description: GRAVITY 25% REDUCTION
Repair System Description: GRAVITY PANEL
Maintenance Agreement Required: ☐ Yes ☑ No


☐ House/Mod. Home No. Bedrooms 3
☑ Mobile Home No. Bathrooms 2
☐ Business No. Employees
☐ Other
☐ Slab ☐ Crawl Space ☐ Basement w/plumbing ☐ Basement wo/plumbing

Water Supply: ☑ Individual ☐ Public ☐ Community


Comments:/Conditions:

Comments:/Conditions: SYSTEM AND MH SITE ACCEPTED AS SHOWN BELOW WITH PRIOR HEALTH DEPT. APPROVAL. SEPTIC TANK W/ MARKER INSTALLED USING "POLYLOK" FILTER. SYSTEM INSTALLED DURING PERIOD OF WET SOIL CONDITIONS.

INITIAL SITE SKETCH 1"=50'

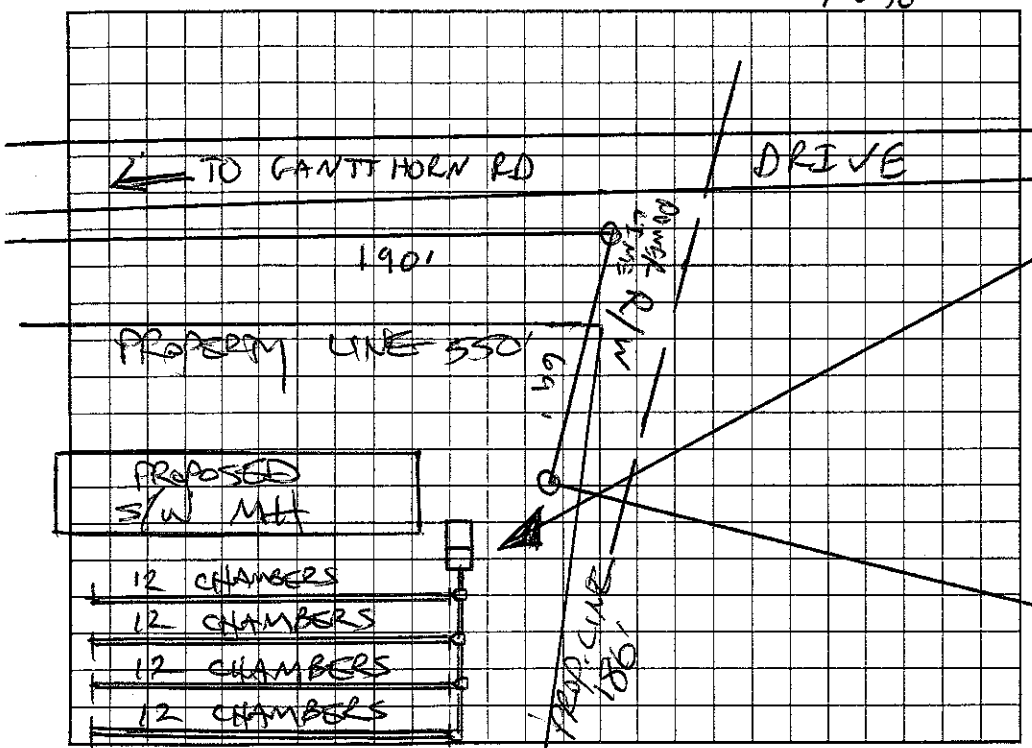

AS BUILT SKETCH

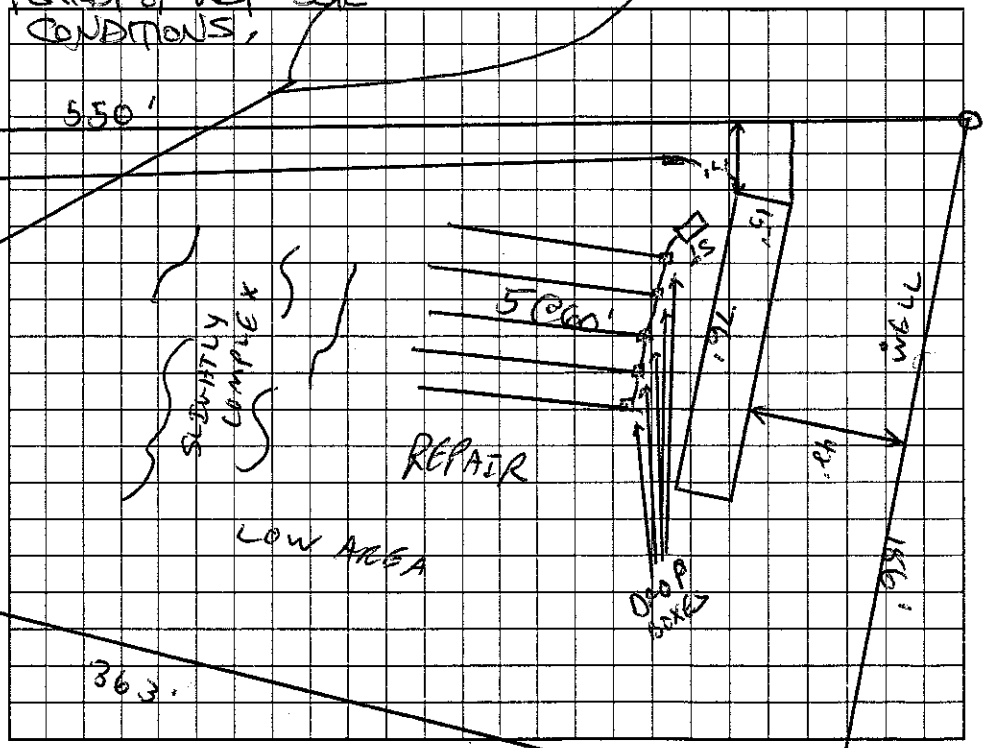

Permit can be suspended or revoked if any false information is supplied toward securing the permit/any unauthorized changes are made to the site/any unauthorized changes are made in the installation of the system. Improvement Permit with plat valid without expiration. Improvement Permit with site plan valid for sixty months. Authorization to Construct is valid for a period equal to that of Improvement Permit – not to exceed sixty months.

Signed: Regina K Cecil date 12/6/02 Installed by: ROWAN SEPTIC TANK

Improvement Permit by: C. Hyatt RS date 12/11/02 Operation Permit by: STEVE HERRICK date 6-12-03

Authorization to Construct by: C. Hyatt RS date 12/11/02 Existing System Inspection by: date

HEALTH DEPT. COPY: WHITE OWNER COPY (FINAL): YELLOW OWNER COPY (INITIAL): PINK