IREDELL COUNTY HEALTH DEPARTMENT - *ENVIRONMENTAL HEALTH* ☒ STATESVILLE OFFICE 704-878-5305 ☐ MOORESVILLE OFFICE 704-664-5281

IMPROVEMENT PERMIT / AUTHORIZATION TO CONSTRUCT / OPERATION PERMIT / EXISTING SYSTEM INSPECTION

PERMIT # 16826 PIN # 4788-08-2295 DATE May 20, 2011

OWNER Dennis + Diane Holland APPLICANT: PHONE: Home/Cell # Business #

SITE ADDRESS 138 Bethel Dr. Harmony OWNER / APPLICANT ADDRESS

SITE DIRECTIONS US 21 N TR Rt. Bethel Rd. TL Thomas Lake Dr. TL Flake Rd. TR Bethel Rd on Left

SUBDIVISION BLOCK / SECTION LOT # LOT AREA DESIGN FLOW L.T.A.R.

Septic Tank Existing Gallons: STB Date

Pump Tank Existing Gallons: P T Date

Pump Make Model Serial #

No. Nitrification Fields: No. Lines Linear Feet

Trench Width Existing Max. Trench Bottom Depth Gravel Depth

☐ New System ☐ Repair ☐ Expansion System Type I II ☒ III IV V VI

System Description:

Repair System Description:

Maintenance Agreement Required ☐ YES ☐ NO

☐ GRAVITY ☒ PRESSURE

☒ Residence No. Bedrooms

☐ Business No. Persons

☐ Other No. Employees

☐ Slab ☐ Crawl Space

☐ Basement w/plumbing ☐ Basement w/o plumbing

Water Supply: ☒ Private ☐ Public ☐ Community

Comments / Conditions

Pool site does not appear to affect septic system. Record not located for septic system, but would be Type IIB or IIA.

INITIAL SITE SKETCH


AS BUILT SKETCH

Location of the proposed Handicap Ramp addition does not appear to impact the existing on-site septic system.**NOTE:

REHS

Date: 10-23-13

ICHD-Environmental Health Division

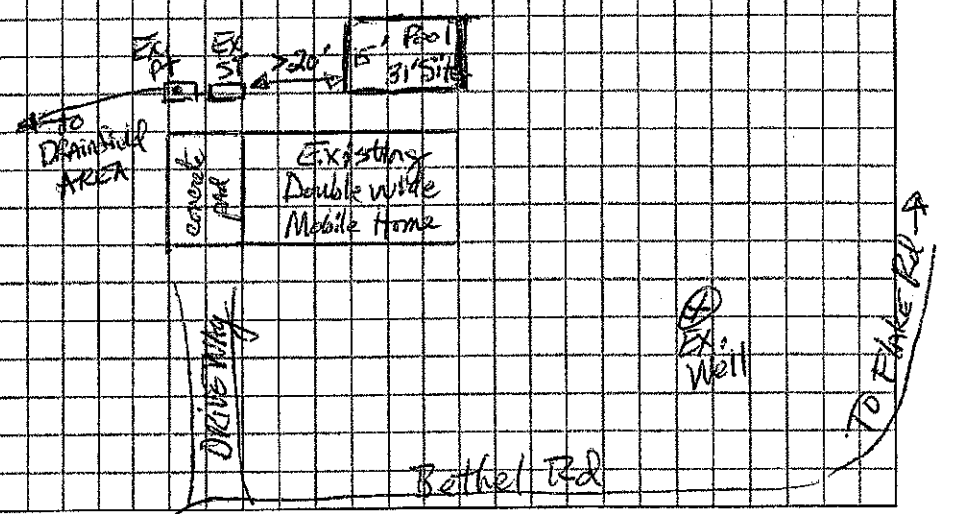

Permit can be suspended or revoked if any false information is supplied toward securing the permit / any unauthorized changes are made to the site / any unauthorized changes are made in the installation of the system.

☐ ***IMPROVEMENT PERMIT*** *with plat valid without expiration.* ☐ ***IMPROVEMENT PERMIT*** *with plat valid without expiration.* site plan valid 60 mo. ☐ ***AUTHORIZATION TO CONSTRUCT*** valid for period equal to IMPROVEMENT PERMIT--not to exceed 60 mo.

Owner / Applicant Signature: Date 5-24-11 Installed by:

IMPROVEMENT PERMIT by: REHS Date

AUTHORIZATION TO CONSTRUCT by: REHS Date

OPERATION PERMIT by: REHS Date

Existing System Inspected by: REHS Date 5-20-11

YOU SHOULD CONTACT A LOCATOR SERVICE PRIOR TO ANY EXCAVATION

White Copy – Environmental Health YELLOW COPY (Final) Owner / Applicant PINK COPY (Initial) Owner / Applicant