IREDELL COUNTY HEALTH DEPARTMENT

STATESVILLE 704-878-5305 (C1) MOORESVILLE 704-664-5281

IMPROVEMENT PERMIT / AUTHORIZATION TO CONSTRUCT / OPERATION PERMIT / EXISTING SYSTEM INSPECTION

PERMIT# 090581 PIN# 4788110941 PT DATE 6/14/02

OWNER OR CONTRACTOR DIXIELAND INC PHONE: Business 828-478-5331 Home

ADDRESS 154 BETHANY RD STATESVILLE NC 28625

LOCATION OLD MOCKSVILLE RD - TR GANTT HORN - ON RT, 0.8 MILE ON RIGHT

SUBDIVISION EVANS ACRES BLOCK / SECTION LOT 3 LOT AREA 1.8AC SITE CLASS PS DESIGN FLOW 360GPD L.T.A.R. .30 LOT/FT2

Septic Tank: 1000 Gallons: STB 825 Date 6-02-02
Pump Tank: Gallons: PT Date
Pump Make: Model Serial No
Nitrification Field: No Fields 1 Square Feet 900 Linear Feet 300
No Lines 3 @ 100' Trench Width 36" Max Trench Bottom Depth 36" Gravel Depth N/A

~~New System~~ Repair System Type: I, II, III, IV, V, VI
System Description: GRAVITY 25% REDUCTION
Repair System Description: ~~SM~~ LP PANEL
Maintenance Agreement Required: Yes ~~No~~
Slab Crawl Space Basement w/plumbing Basement wo/plumbing


~~House~~/Mod Home No. Bedrooms 3
Mobile Home No. Bathrooms 3
Business No. Employees
Other

Water Supply: ~~Individual~~ Public Community

Comments:/Conditions:

Comments /Conditions: SEPTIC TANK WITH MARKER INSTALLED USING "POLY LOK" FILTER

INITIAL SITE SKETCH 1" = 60'

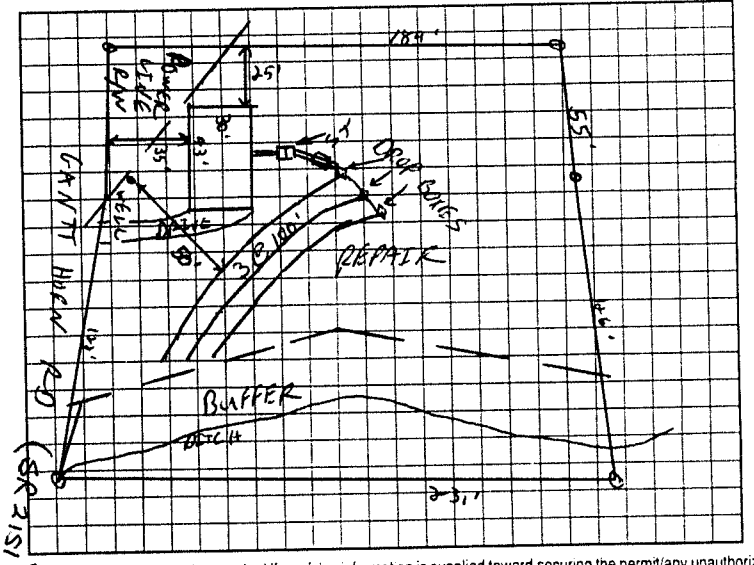

AS BUILT SKETCH

SYSTEM INSTALLED ACCORDING TO INITAL SITE SKETCH USING 48 "INFILTRATOR" CHAMBERS

Permit can be suspended or revoked if any false information is supplied toward securing the permit/any unauthorized changes are made to the site/any unauthorized changes are made in the installation of the system. Improvement Permit with plat valid without expiration. Improvement Permit with site plan valid for sixty months. Authorization to Construct is valid for a period equal to that of Improvement Permit – not to exceed sixty months.

Signed: Ginger Cecil date 4/24/02 Installed by: ROWAN SEPTIC TANK

Improvement Permit by: CTS KS date 6/14/02 Operation Permit by: STEVE HENDRICK date 8-13-02

Authorization to Construct by: CTS KS date 6/14/02 Existing System Inspection by: date

HEALTH DEPT COPY WHITE OWNER COPY (FINAL) YELLOW OWNER COPY (INITIAL) PINK