Paid 175.00 D4 3.00

IREDELL COUNTY HEALTH DEPARTMENT

STATESVILLE 704-878-5305 MOORESVILLE 704-664-5281

IMPROVEMENT PERMIT / AUTHORIZATION TO CONSTRUCT / OPERATION PERMIT / EXISTING SYSTEM INSPECTION

DATE 9/13/00

PERMIT# 90580 PIN# 4768110941 PT

OWNER OR CONTRACTOR DIXIELAND INC PHONE: Business 828-478-5331 Home

ADDRESS 154 BETHANY RD STATESVILLE NC 28625

LOCATION OLD MOCKSVILLE RD - TR GANTT HORN - ON RT

SUBDIVISION EVANS ACRES BLOCK / SECTION LOT 2 LOT AREA .55AC SITE CLASS PS DESIGN FLOW 360 GPD L.T.A.R. .3 GPD/FT²

Septic Tank: 1000 Gallons; STB 825 Date 9/27/00

Pump Tank: Gallons; PT Date

Pump Make: Model Serial No.

Nitrification Field: No Fields 1 Square Feet 900 Linear Feet 300

No Lines 4@75' Trench Width 36" Max Trench Bottom Depth 36"

☒ New System ☐ Repair System Type: I. II. (III) IV. V. VI

System Description: GRAVITY INNOVATIVE

Repair System Description: GRAVITY PANEL

Maintenance Agreement Required: ☐ Yes ☐ No

Gravel Depth N/A ☐ Slab ☐ Crawl Space ☐ Basement w/plumbing ☐ Basement wo/plumbing

☐ House/Mod. Home No. Bedrooms 3

☐ Mobile Home No. Bathrooms 2

☐ Business No. Employees

☐ Other


Water Supply: ☐ Individual ☐ Public ☐ Community

Comments:/Conditions:

Comments:/Conditions: Poly lok Filter

S-S Flow installed

INITIAL SITE SKETCH 1"=50'

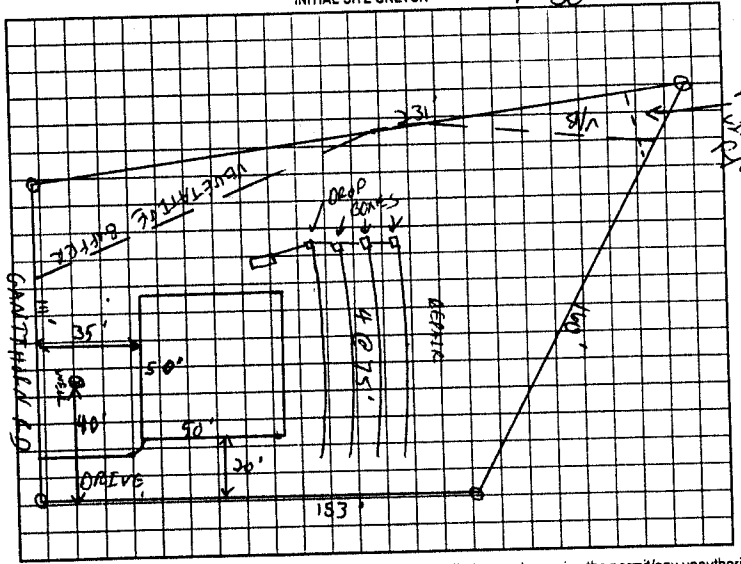

AS BUILT SKETCH

Permit can be suspended or revoked if any false information is supplied toward securing the permit/any unauthorized changes are made to the site/any unauthorized changes are made in the installation of the system. Improvement Permit with plat valid without expiration. Improvement Permit with site plan valid for sixty months. Authorization to Construct is valid for a period equal to that of Improvement Permit – not to exceed sixty months.

Signed: Regina Cecil date 9/15/00

Improvement Permit by: C. Hyatt for RS date 9/13/00

Authorization to Construct by: C. Hyatt for RS date 9/13/00

Installed by: Rowan Septic

Operation Permit by: in NV / SI date 10/31/00

Existing System Inspection by: date

HEALTH DEPT. COPY: WHITE OWNER COPY (FINAL) YELLOW OWNER COPY (INITIAL) PINK