IREDELL COUNTY HEALTH DEPARTMENT

STATESVILLE 704-878-5305 MOORESVILLE 704-664-5281

IMPROVEMENT PERMIT / CERTIFICATE OF COMPLETION / OPERATION PERMIT / EXISTING SYSTEM INSPECTION

PROPERTY DESCRIPTION NO. 26340 06-1944 DATE 6/3/97 TAX MAP NO. 4788 13944 Watershed: ☐ Yes ☐ No

OWNER OR CONTRACTOR Marcoe Cortner PHONE: Business Home 546-5741

ADDRESS 2274 Old Mocksville Rd statesville NC 28677

LOCATION Old Mocksville Road, Pass Cahntt Home 1/4 mile on Rt

SUBDIVISION BLOCK / SECTION LOT LOT AREA 1AU acre SITE CLASS. PS DESIGN FLOW 900 L.T.A.R. 0.3 gpd/ft²

Septic Tank: 1000 Gallons; STB 425 Date 7-11-97

Pump Tank: Gallons; PT Date

Pump Make: Model Serial No.

Nitrification Field: No Fields I Square Feet 1200 Linear Feet 400

No Lines 400 Trench Width 36" Max Trench Bottom Depth 36" Gravel Depth 12"

☑ New System ☐ Repair System Type: I, II, III, IV, V, VI

System Description: Conventional Equit

Repair System Description: Conventional Septic

Maintenance Agreement Required: ☐ Yes ☑ No

☐ House/Mod. Home ☑ Mobile Home ☐ Business ☐ Other

No. Bedrooms 3 No. Bathrooms 2 No. Employees

☐ Slab ☑ Crawl Space ☐ Basement w/plumbing ☐ Basement wo/plumbing

Water Supply: ☑ Individual ☐ Community ☐ Public To Be Drilled


Comments:

Keep lines on Contour 10' fom lot line


Keep new well 100' from all septic areas

Comments:

INITIAL SITE SKETCH

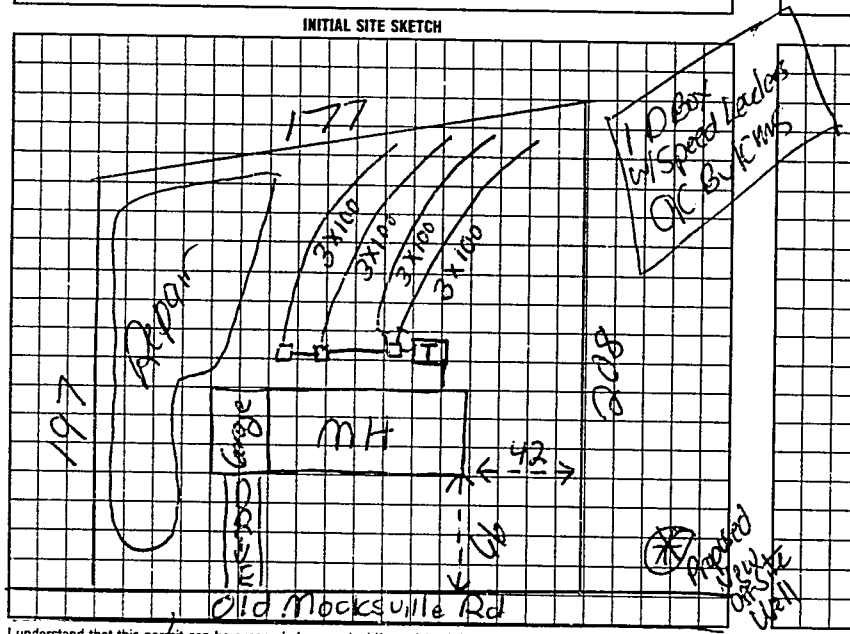

AS BUILT SKETCH

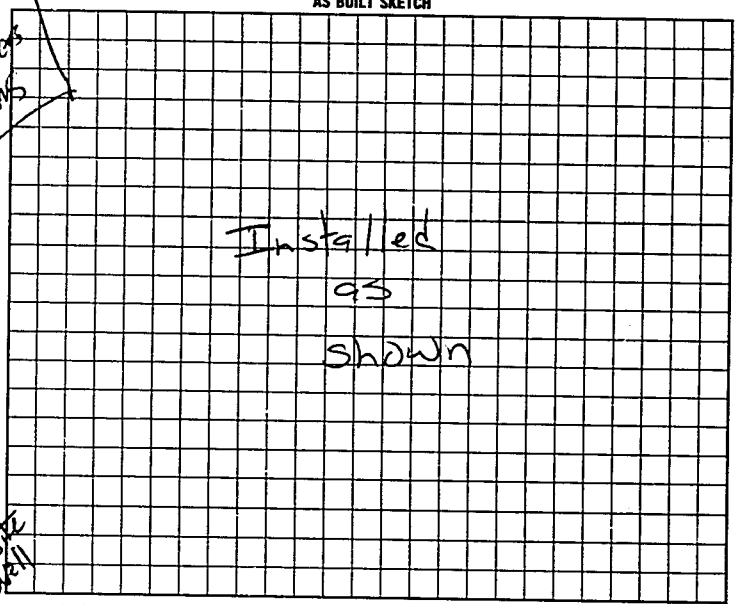

I understand that this permit can be suspended or revoked if any false information is supplied toward securing the permit/any unauthorized changes are made to the site/any unauthorized changes are made in the installation of the system. Improvement Permit is valid for 60 months from date of issuance.

Signed: Matthew Martin

Improvement Permit by date 6/4/97

Existing System Inspection by date

Installed by: Ronnie Dye

Certificate of Completion by date

Operation Permit by date 9-3-97

HEALTH DEPT COPY WHITE INSPECTION COPY (FINAL) GREEN OWNER COPY (FINAL) YELLOW INSPECTION COPY (INITIAL) PINK OWNER COPY (INITIAL) GOLD

S 20000