IREDELL COUNTY HEALTH DEPARTMENT

STATESVILLE 704-878-5305 MOORESVILLE 704-664-5281

IMPROVEMENT PERMIT / CERTIFICATE OF COMPLETION / OPERATION PERMIT / EXISTING SYSTEM INSPECTION

PROPERTY DESCRIPTION NO. 18935 DATE 8/12/94 TAX MAP NO. 12D-1-A-7 Watershed: ☐ Yes ☑ No

OWNER OR CONTRACTOR CAROLAN T. CRAIG JR PHONE: Business Home (910) 766-1111

ADDRESS 1646 CHARDALE DR #16 CLEMMONS, NC 27012

LOCATION I-40 E, TL ON MOCKSVILLE ROAD NE, 1ST LOT ON (L) PAST VAUGHN MILL RD.

SUBDIVISION R.C. CARTNER, EST BLOCK / SECTION LOT 2 LOT AREA 4 AC SITE CLASS. PS DESIGN FLOW 360 L.T.A.R. 0.33 GPD/FT2

Septic Tank: 1000 Gallons; STB 794 Date 2/22/95

Pump Tank: Gallons; PT Date

Pump Make: Model Serial No.

Nitrification Field: No Fields 1 Square Feet 1080 Linear Feet 360

No Lines 3 Trench Width 36" Max Trench Bottom Depth 28-36" Gravel Depth 12"

☑ New System ☐ Repair System Type: I, II, III, IV, V, VI

System Description: CONVENTIONAL GRAVITY

Repair System Description: CONV. GRAVITY

Maintenance Agreement Required: ☐ Yes ☑ No

☐ House/Mod. Home ☑ Mobile Home ☐ Business ☐ Other

No. Bedrooms 3 No. Bathrooms 2 No. Employees


☐ Slab ☑ Crawl Space ☐ Basement w/plumbing ☐ Basement wo/plumbing

Water Supply: ☑ Individual ☐ Community ☐ Public WELL

Comments: (1) KEEP SYSTEM MINIMUM 5' FROM MH, 10' FROM PROPERTY LINE, 100' FROM WELL. (2) INSTALL LINES ON CONTOUR. NO DEEPER THAN 36", 9' APART ON CENTER.

Comments:

INITIAL SITE SKETCH

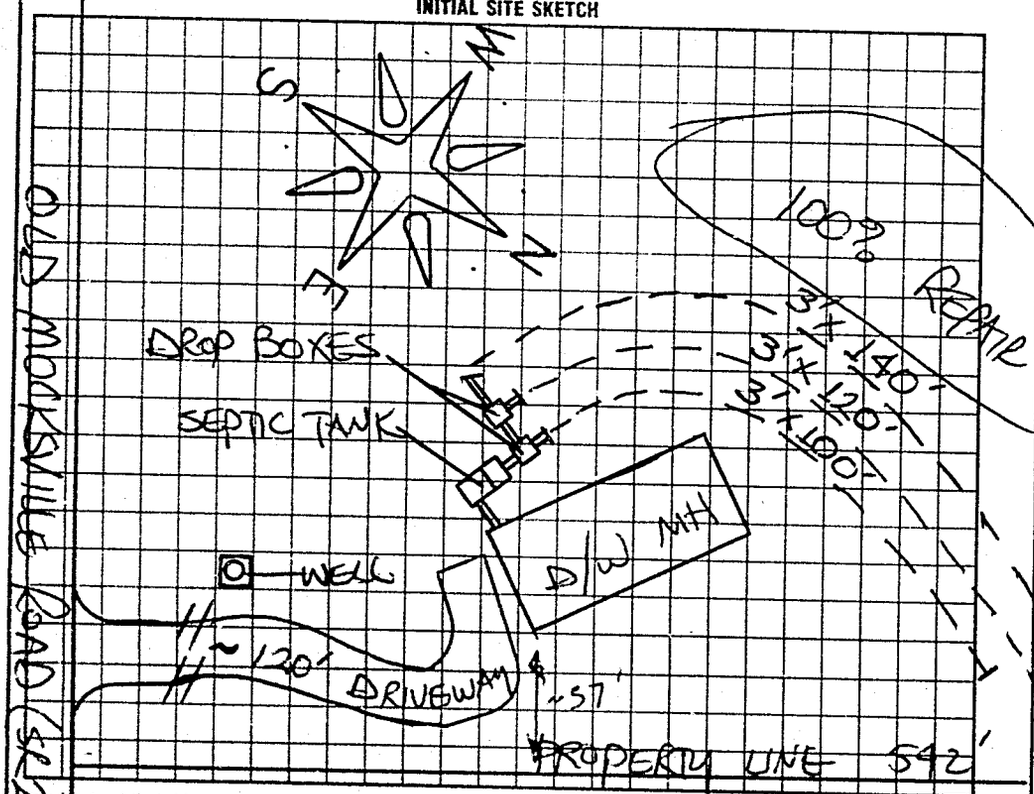

AS BUILT SKETCH

SYSTEM INSTALLED ACCORDING TO INITAL SITE SKETCH

I understand that this permit can be suspended or revoked if any false information is supplied toward securing the permit/any unauthorized changes are made to the site/any unauthorized changes are made in the installation of the system. Improvement Permit is valid for 60 months from date of issuance.

Signed: X C.J. Craig Jr.

Improvement Permit by: STEVE HEDRICK date 8/12/94

Existing System Inspection by: date

Installed by: JAMES HUDLER

Certificate of Completion by: STEVE HEDRICK date 4/18/95

Operation Permit by: date

HEALTH DEPT COPY: WHITE INSPECTION COPY (FINAL): GREEN OWNER COPY (FINAL): YELLOW INSPECTION COPY (INITIAL): PINK OWNER COPY (INITIAL): GOLD