IREDELL COUNTY HEALTH DEPARTMENT

Statesville Office (704) 878-5305 Mooresville Office (704) 660-3625 PERMIT # 177809

IMPROVEMENT PERMIT / AUTHORIZATION TO CONSTRUCT / OPERATION PERMIT / EXISTING SYSTEM

PIN # 4788492075

APPLICANT: D R Cartner APPLICANT ADDRESS: 143 Cartner Rd.

SITE ADDRESS: 143 Cartner Rd. PHONE: 704-546-7294 ALT. PHONE: 704-880-7160

SITE DIRECTIONS: Old Mocksville Rd TL Cartner Rd. 1st Home on Left

SUBDIVISION: N/A SECTION: N/A LOT # N/A LOT AREA: 0.65 acres DESIGN FLOW: 240 gpd L.T.A.R.: Existing

Septic Tank Existing (gal) STB Date

Pump Tank (gal) PT Date

Pump Make Model Serial #

Nitrification Fields 1 # Lines 6x Linear Ft: Gx.

Trench Width Gx Max. Trench Bottom Depth 6x. Gravel Depth 6x.

☐ New System ☐ Repair ☐ Expansion System Type: I (II) III IV V VI

System Description: Conventional

Repair System Description:

Maintenance Agreement Required: ☐ YES ☑ NO

☑ GRAVITY ☐ PRESSURE

☑ Residence No. Bedrooms 2

☐ Business No. Persons

☐ Other No. Employees

☐ Slab ☑ Crawl Space

☐ Basement w/plumbing ☐ Basement w/o plumbing

Water Supply

☑ Private

☐ Public


☐ Community

Comments / Conditions:

- Maintain a minimum of 5' between home foundation and all components of septic tank system.
- Plumb washing machine into septic tank.

INITIAL SITE SKETCH

AS BUILT SKETCH

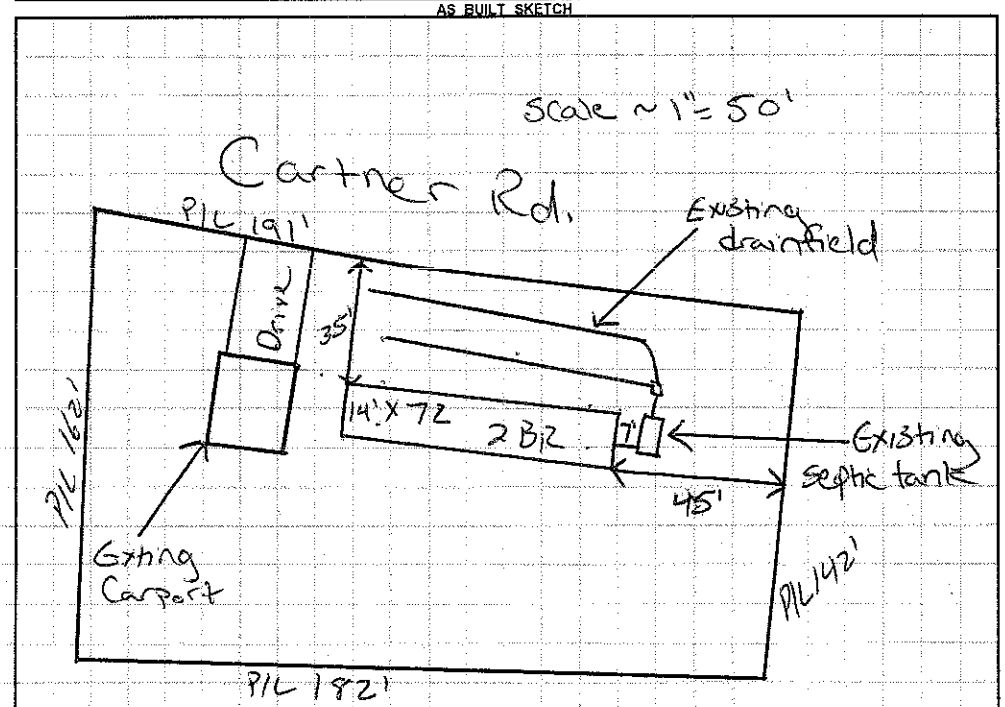

Permit can be suspended or revoked if any false information is supplied toward securing the permit / any unauthorized changes are made to the site / any unauthorized changes are made in the installation of the system. **CONTACT A LOCATOR SERVICE PRIOR TO ANY EXCAVATION**

☐ **IMPROVEMENT PERMIT** ***with plat*** *valid without expiration.* ☐ **IMPROVEMENT PERMIT** ***with site plan*** *valid for 60 mos.* ☐ **AUTHORIZATION TO CONSTRUCT** *valid for period equal to IMPROVEMENT PERMIT--not to exceed 60 mo.*

Owner / Applicant Signature: D R Cartner Jr Date: 4.9.13 Installed by:

IMPROVEMENT PERMIT by: Date: OPERATION PERMIT by: Date:

AUTHORIZATION TO CONSTRUCT by: Date: Existing System Inspected by: Justin Henderson Date: 4-8-13

Health Dept. Copy - WHITE Applicant (Final Approval) - YELLOW Applicant (Conditional Approval) - PINK