IREDELL COUNTY HEALTH DEPARTMENT

STATESVILLE 704-878-5305 MOORESVILLE 704-664-5281

IMPROVEMENT PERMIT / CERTIFICATE OF COMPLETION / OPERATION PERMIT / EXISTING SYSTEM INSPECTION

PROPERTY DESCRIPTION NO. 20959 DATE 4/27/95 TAX MAP NO. 12D-A-55 (PART OF) Watershed: ☐ Yes ☑ No

OWNER OR CONTRACTOR WILLIAM TERRY SNYDER PHONE: Business _____ Home 546-7117

ADDRESS 226 STROUD ROAD, STATESVILLE, NC 28677

LOCATION OLD MOCKSVILLE RD NE, TR VAUGHN MILL RD, TR STROUD RD, LOT ON RIGHT BEFORE END.

SUBDIVISION _____ BLOCK / SECTION _____ LOT _____ LOT AREA 1.5 ACRES SITE CLASS. PS DESIGN FLOW 360 L.T.A.R. EXISTING

Septic Tank: 1000 Gallons; STB _____ Date _____

Pump Tank: _____ Gallons; PT _____ Date _____

Pump Make: _____ Model _____ Serial No. _____

Nitrification Field: No Fields 1 Square Feet 720 Linear Feet 240

No Lines 2 Trench Width _____ Max Trench Bottom Depth _____ Gravel Depth 12

☐ New System ☐ Repair System Type: ☐ I ☐ II ☐ III ☐ IV ☐ V ☐ VI

System Description: CONVENTIONAL GRAVITY

Repair System Description: _____

Maintenance Agreement Required: ☐ Yes ☑ No

☑ House/Mod. Home No. Bedrooms 3

[redacted] No. Bathrooms 2½

☐ Business No. Employees _____

☐ Other _____


☐ Slab [redacted] ☐ Basement w/plumbing ☑ Basement wo/plumbing

Water Supply: ☑ Individual ☐ Community ☐ Public WELL


Comments:

Comments: ① MH TO BE REMOVED UPON OCCUPANCY OF HOUSE ② WELL LOCATED WITHIN 25' [redacted] OF PROPOSED HOUSE SITE

INITIAL SITE SKETCH

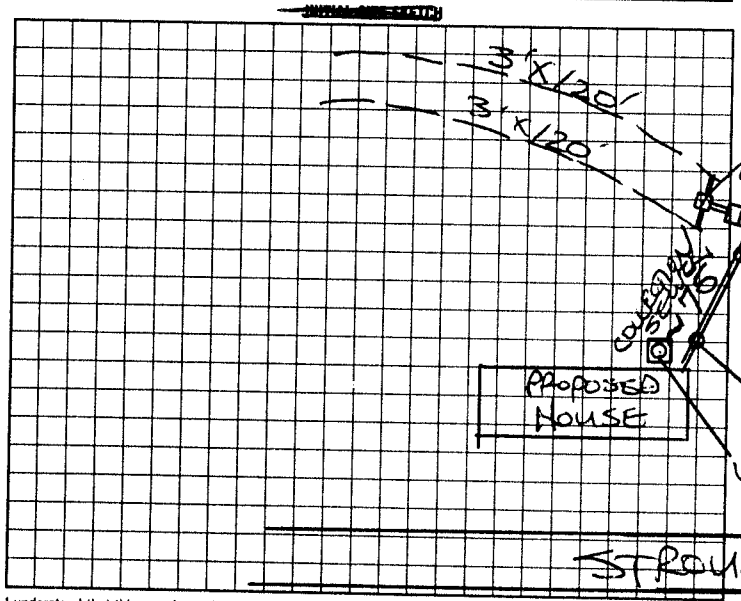

AS BUILT SKETCH

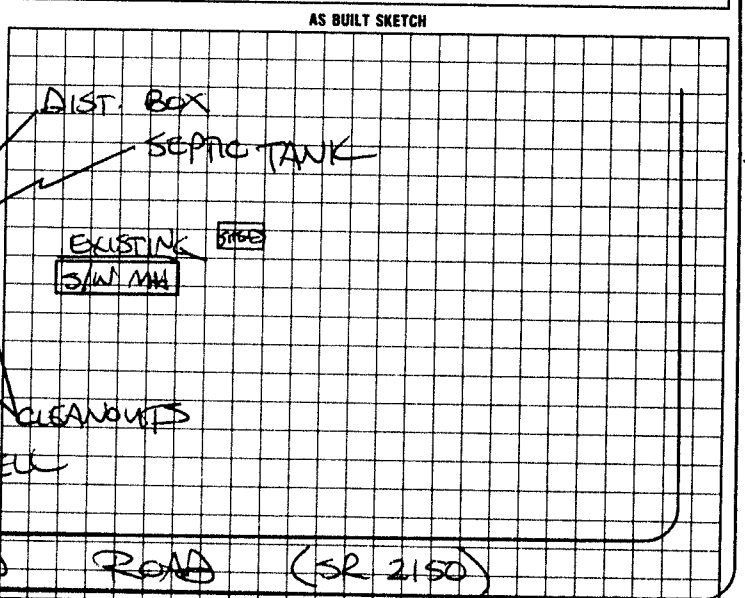

I understand that this permit can be suspended or revoked if any false information is supplied toward securing the permit/any unauthorized changes are made to the site/any unauthorized changes are made in the installation of the system. Improvement Permit is valid for 60 months from date of issuance.

Signed: _____

Improvement Permit by: _____ date _____

Existing System Inspection by: STEVE HEDRICK date 4/27/95

Installed by: _____

Certificate of Completion by: _____ date _____

Operation Permit by: _____ date _____

HEALTH DEPT. COPY: WHITE INSPECTION COPY (FINAL): GREEN OWNER COPY (FINAL): YELLOW INSPECTION COPY (INITIAL): PINK OWNER COPY (INITIAL): GOLD