IREDELL COUNTY HEALTH DEPARTMENT

STATESVILLE 704-878-5305 MOORESVILLE 704-664-5281

IMPROVEMENT PERMIT / AUTHORIZATION TO CONSTRUCT / OPERATION PERMIT / EXISTING SYSTEM INSPECTION

PERMIT# 150665 PIN# 4788538665 DATE 6-24-08

OWNER OR APPLICANT Lex Maynard PHONE: Business 704-902-8375 Home

ADDRESS 396 Vaugh Mill Rd Statesville 28625

LOCATION I-40 E to Salem Church Rd to Vaughn Mill Corner of Stuart

SUBDIVISION BLOCK/SECTION LOT LOT AREA 4.11 SITE CLASS. B/C DESIGN FLOW 360 L.T.A.R. .3

Septic Tank: 1020 Gallons: STB 760 Date 8-26-08

Pump Tank: Gallons: PT Date

Pump Make: Model Serial No.

Nitrification Field: No Fields Square Feet 1200 Linear Feet 300

No Lines 3 Trench Width 36" Max Trench Bottom Depth 30"

☑ New System ☐ Repair ☐ Expansion System Type: I II III IV V VI

System Description: 25% Expansion

Repair System Description: 25% Expansion

Maintenance Agreement Required: ☐ Yes ☐ No

Gravel Depth N/A ☑ Gravity ☐ Pressure

☐ House/Mod. Home No. Bedrooms 3

☐ Mobile Home No. Persons

☐ Business No. Employees

☐ Other

Water Supply: ☐ Individual ☑ Public ☐ Community

☐ Slab ☑ Crawl Space ☐ Basement w/plumbing ☐ Basement wo/plumbing


Comments:/Conditions:

Comments:/Conditions:


Install on Contour

Maintain all setbacks

INITIAL SITE SKETCH

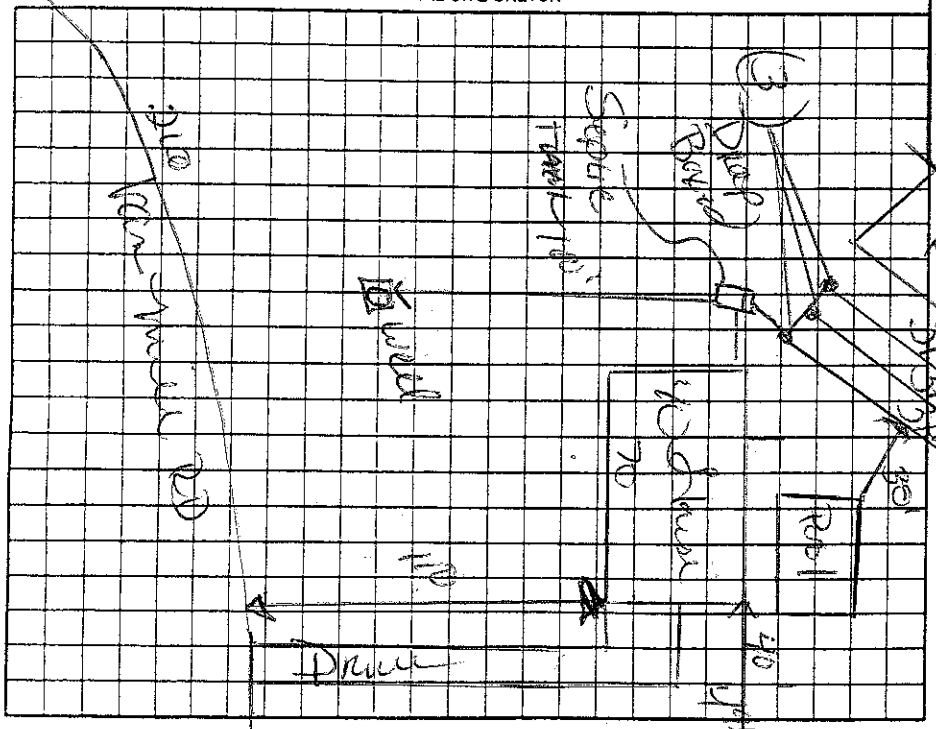

AS BUILT SKETCH

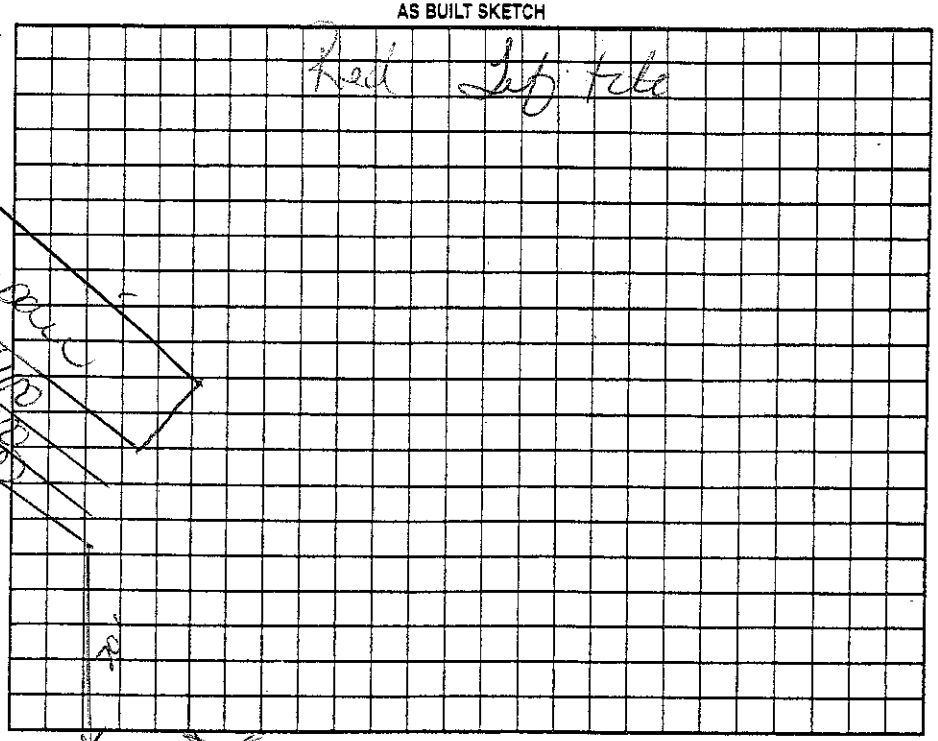

Permit can be suspended or revoked if any false information is supplied toward securing the permit, any unauthorized changes are made to the site, any unauthorized changes are made in the installation of the system. Improvement Permit with plat valid without expiration ☐ Improvement Permit with site plan valid for sixty months ☑ Authorization to Construct is valid for a period equal to that of Improvement Permit – not to exceed sixty months.

Signed: Kami Robertson date 9-25-08

Improvement Permit by: Ken Cook date 6-24-08

Authorization to Construct by: Ken Cook date 6-24-08

Installed by: Abel Grading

Operation Permit by: Ken Cook date 2-23-09

Existing System Inspection by: date

HEALTH DEPT. COPY: WHITE OWNER COPY (FINAL): YELLOW OWNER COPY (INITIAL): PINK