IREDELL COUNTY HEALTH DEPARTMENT

STATESVILLE 704-878-5305 (CI) MOORESVILLE 704-664-5281

IMPROVEMENT PERMIT / AUTHORIZATION TO CONSTRUCT / OPERATION PERMIT / EXISTING SYSTEM INSPECTION

PERMIT# 115731 PIN# ~~4788-53-9672.1~~ 4788-63-0669 DATE 9-29-03

OWNER OR CONTRACTOR FLEETWOOD HOMES OF TROUTMAN PHONE: Business 704-528-7128 Home

ADDRESS 1040 CHARLOTTE HWY TROUTMAN, NC 28166

LOCATION ~~(63)~~ OLD MOORESVILLE RD NORTH, (R) VAUGHN MILL ON LEFT ACROSS FROM

SUBDIVISION BLOCK / SECTION LOT LOT AREA ≈2.43 AC SITE CLASS PS DESIGN FLOW 360 L.T.A.R. .3

Septic Tank: 1000 Gallons; STB 1012 Date 9-30-03
Pump Tank: Gallons; PT Date
Pump Make: Model Serial No.
Nitrification Field: No Fields 1 Square Feet 1200' Linear Feet 400'
No Lines 3x133' Trench Width 36" Max Trench Bottom Depth 36"

(X) New System ( ) Repair System Type: I, (II) III, IV, V, VI
System Description: CONV GRAV
Repair System Description: SAME
Maintenance Agreement Required: ( ) Yes (X) No


( ) House/Mod. Home No. Bedrooms 3
(X) Mobile Home No. Bathrooms 2
( ) Business No. Employees
( ) Other
Gravel Depth 12" ( ) Slab (X) Crawl Space ( ) Basement w/plumbing ( ) Basement wo/plumbing

Water Supply: (X) Individual ( ) Public ( ) Community

Comments:/Conditions: (1) AFTER CLEARING LOT CALL FOR FLAGGING (2) MAINTAIN SETBACKS (3) INSTALL LINES ON CONTOURS (4) KEEP WELL 100' FROM SYSTEM.


Comments:/Conditions: TUFFTITE FILTER
& MARKER
SYSTEM NEEDS 30' MORE OF LINE ADDED. 10-24-03

INITIAL SITE SKETCH NOT TO SCALE

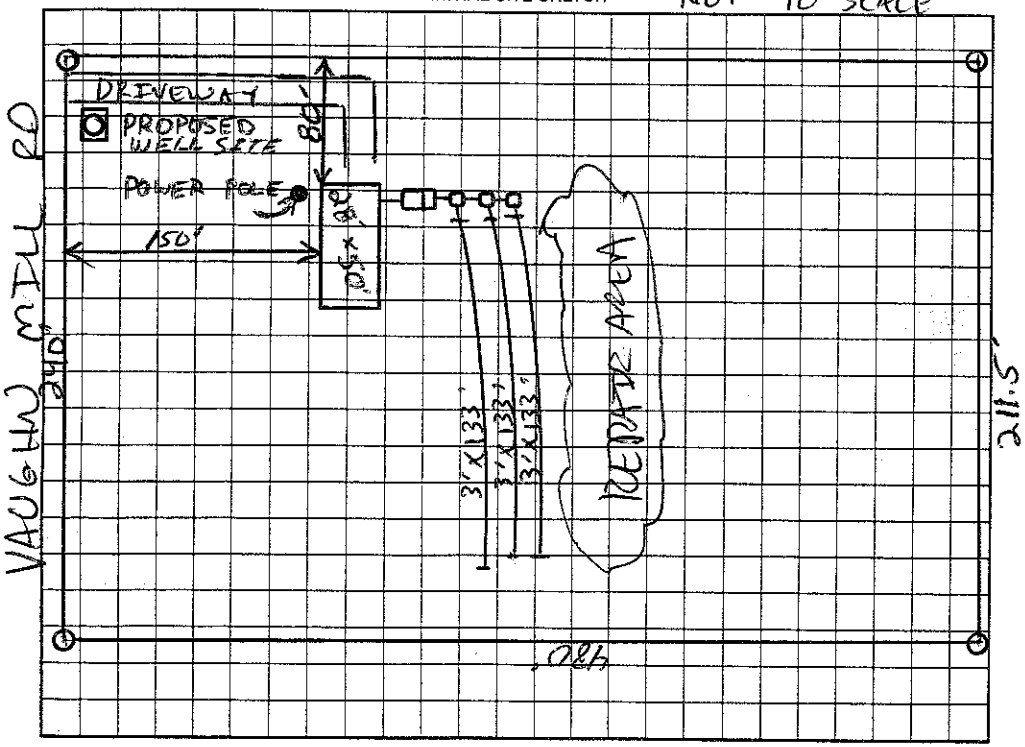

AS BUILT SKETCH

10-27-03 W/ 30' OF LINE OK, LC
SYSTEM MOVED BECAUSE WELL WAS TOO CLOSE TO WHERE HOME. LC

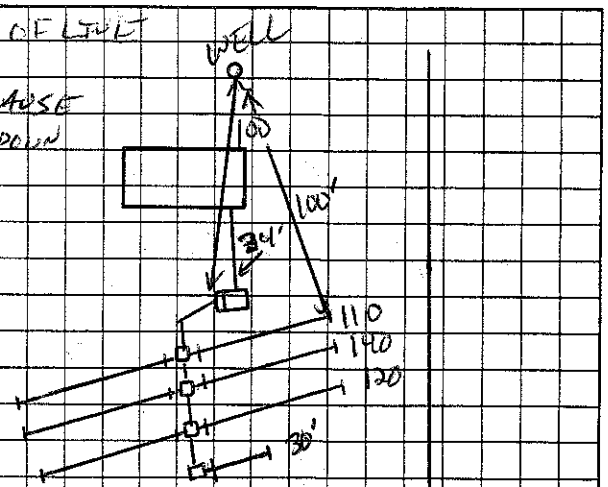

Permit can be suspended or revoked if any false information is supplied toward securing the permit/any unauthorized changes are made to the site/any unauthorized changes are made in the installation of the system. Improvement Permit with plat valid without expiration. Improvement Permit with site plan valid for sixty months. Authorization to Construct is valid for a period equal to that of Improvement Permit – not to exceed sixty months.

Signed: date 9-29-03 Installed by: CRAIG THOMPSON

Improvement Permit by: date 9-29-03 Operation Permit by: date 10-27-03

Authorization to Construct by: date 9-29-03 Existing System Inspection by: date

HEALTH DEPT. COPY: WHITE OWNER COPY (FINAL): YELLOW OWNER COPY (INITIAL): PINK