IREDELL COUNTY HEALTH DEPARTMENT

STATESVILLE 704-878-5305 (at) MOORESVILLE 704-664-5281

IMPROVEMENT PERMIT / AUTHORIZATION TO CONSTRUCT / OPERATION PERMIT / EXISTING SYSTEM INSPECTION

PERMIT # 158433 PIN # 4788-89-1321 DATE 10-7-09

OWNER or APPLICANT Bobby Anderson PHONE: Business Home: 704-546-2273

OWNER or APPLICANT ADDRESS 239 Kirby RD Harmony NC 28634

LOCATION / DIRECTIONS Old Mocksville RD (R) Vaughn Mill on Right 1/4 +/- mile

SUBDIVISION BLOCK / SECTION LOT # LOT AREA 1.225 DESIGN FLOW 360 L.T.A.R. .25

Septic Tank 1000 Gallons: STB 1062 Date 7-2-05

Pump Tank Gallons: P T Date

Pump Make Model Serial #

Nitrification Field No Fields No Lines 4 Linear Feet 360

Trench Width 36" Max. Trench Bottom Depth 36" Gravel Depth 12

☒ New System ☐ Repair ☐ Expansion System Type I II (III) IV V VI

System Description: 25% Expansion

Repair System Description 25% Expansion

Maintenance Agreement Required ☐ YES ☒ NO

☒ GRAVITY ☐ PRESSURE

☒ Residence No. Bedrooms 3

☐ Business No. Persons

☐ Other No. Employees

☐ Slab ☐ Crawl Space

☒ Basement w/plumbing ☐ Basement w/o plumbing


Water Supply: ☐ Private ☒ Public ☐ Community

Comments / Conditions


Comments / Conditions

Install an Contour
Maintain all setbacks

INITIAL SITE SKETCH

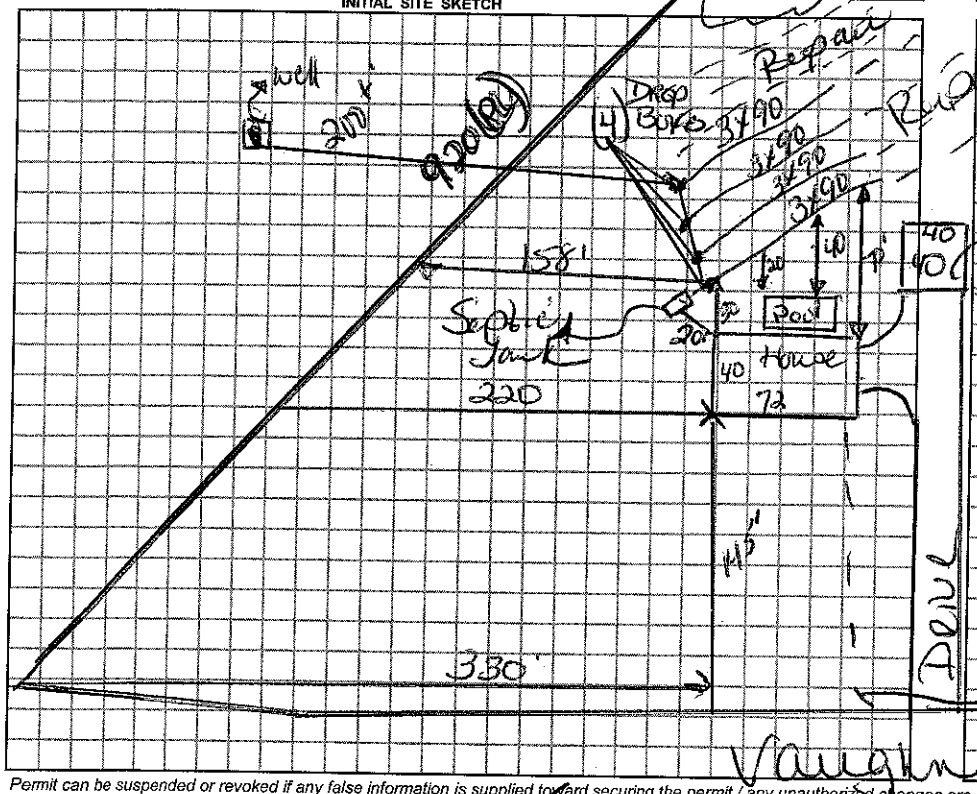

AS BUILT SKETCH

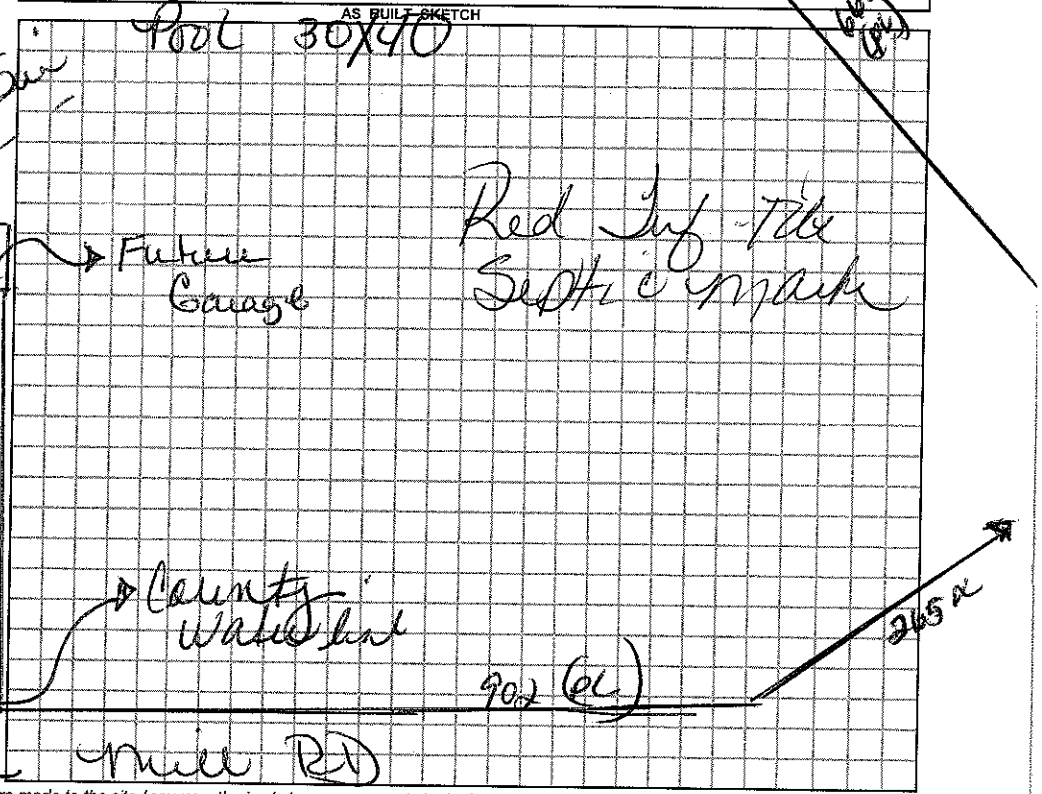

Permit can be suspended or revoked if any false information is supplied toward securing the permit / any unauthorized changes are made to the site / any unauthorized changes are made in the installation of the system.

☐ *IMPROVEMENT PERMIT w / plat valid without expiration.* ☒ *IMPROVEMENT PERMIT w / site plan valid for 60 mos.* ☒ *AUTHORIZATION TO CONSTRUCT valid for period equal to IMPROVEMENT PERMIT-not to exceed 60 mo.*

Owner / Applicant Signature: Bobby Anderson Date 10-8-09

Improvement Permit by: Kelly Cook Date 10-7-09

Authorization to Construct by: Kelly Cook Date 10-7-09

YOU SHOULD CONTACT A LOCATOR SERVICE PRIOR TO ANY EXCAVATION.

Installed by: Johnny Faye

Operation Permit by: Kelly Cook Date: 2-18-10

Existing System Inspected by: Date:

WHITE COPY Environmental Health YELLOW COPY (Final) Owner / Applicant PINK COPY (Initial) Owner / Applicant