IREDELL COUNTY HEALTH DEPARTMENT

STATESVILLE 704-878-5305 MOORESVILLE 704-664-5281

IMPROVEMENT PERMIT / CERTIFICATE OF COMPLETION / OPERATION PERMIT / EXISTING SYSTEM INSPECTION

PROPERTY DESCRIPTION NO. 25966 DATE 1-23-97 PARCEL NO. 4788 88 4122 Watershed: ☐ Yes ☑ No

OWNER OR CONTRACTOR WILLIAM C. ROBERTSON PHONE: Business 873-1014 Home

ADDRESS 1759 MOCKSVILLE HWY CLEVELAND, NC 27013

LOCATION OLD MOCKSVILLE ROAD NB, TR SOCIETY CHURCH ROAD, ON (R) BEHIND 1ST HOUSE

SUBDIVISION BLOCK / SECTION LOT LOT AREA 130 ACRES± SITE CLASS. PS DESIGN FLOW 240 L.T.A.R. 0.334 GPD/FT²

Septic Tank: 1000 Gallons; STB 620 Date 11-10-96

Pump Tank: Gallons; PT Date

Pump Make: Model Serial No.

Nitrification Field: No. Fields 1 Square Feet 720 Linear Feet 240

No. Lines FOUR Trench Width 36" Max Trench Bottom Depth 36" Gravel Depth 12"

☑ New System ☐ Repair System Type: I II III IV V VI

System Description: CONV. GRAVITY

Repair System Description: CONV. GRAVITY

Maintenance Agreement Required: ☐ Yes ☑ No

☐ Slab ☑ Crawl Space ☐ Basement w/plumbing ☐ Basement wo/plumbing

☐ House/Mod. Home No. Bedrooms 2

☑ Mobile Home No. Bathrooms 2

☐ Business No. Employees

☐ Other


Water Supply: ☑ Individual ☐ Community ☐ Public WELL

ON RIGHT AT BOX #224


Comments: USE THREE FLOW DIVIDER TEES TO ACHIEVE EQUAL DIST. INTO EACH OF FOUR LINES

Comments:

INITIAL SITE SKETCH

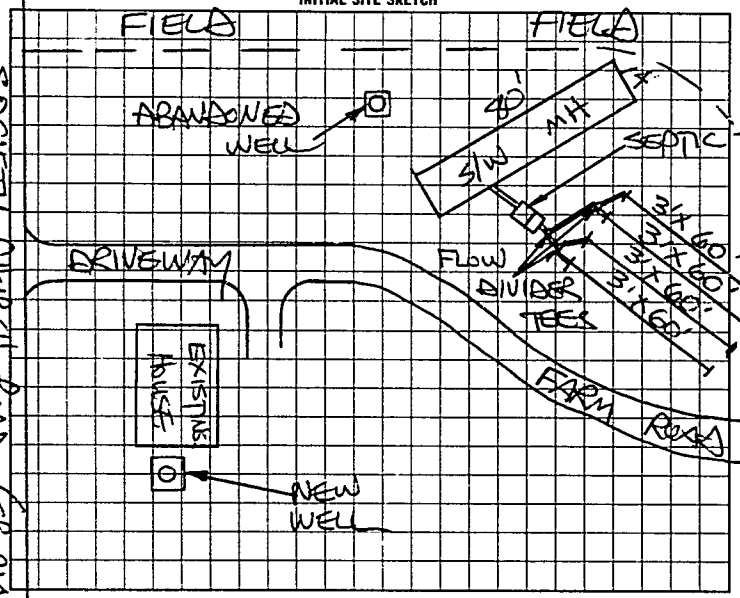

AS BUILT SKETCH

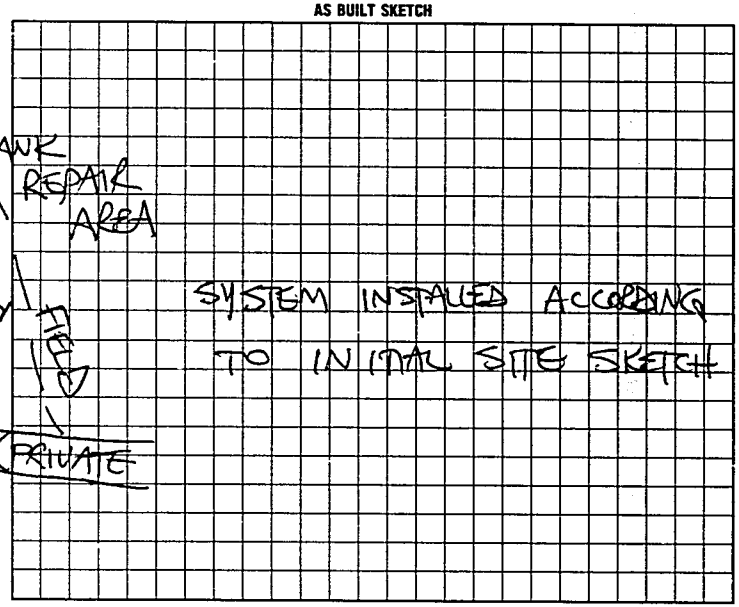

I understand that this permit can be suspended or revoked if any false information is supplied toward securing the permit/any unauthorized changes are made to the site/any unauthorized changes are made in the installation of the system. Improvement Permit is valid for 60 months from date of issuance. AUTH. TO CONSTRUCT IS VALID FOR 60 MONTHS

Signed: X John R. Matthews

Improvement Permit by: STEVE HEDRICK date 1-23-97

Authorization to Construct

Existing System Inspection by: STEVE HEDRICK date 1-23-97

Installed by: SAMMY REAVIS

Certificate of Completion by: date

Operation Permit by: STEVE HEDRICK date 2-21-97

HEALTH DEPT. COPY: WHITE INSPECTION COPY (FINAL): GREEN OWNER COPY (FINAL): YELLOW INSPECTION COPY (INITIAL): PINK OWNER COPY (INITIAL): GOLD

8623200