IREDELL COUNTY HEALTH DEPARTMENT

STATESVILLE 704-878-5305 MOORESVILLE 704-664-5281

IMPROVEMENT PERMIT / AUTHORIZATION TO CONSTRUCT / OPERATION PERMIT / EXISTING SYSTEM INSPECTION

PERMIT# 089091 PIN# 4788 90 8729 (PT) DATE 5-16-2000

OWNER OR CONTRACTOR JOHN SHEETS PHONE: Business Home 873-2547

ADDRESS 331 SUNFLOWER ROAD, STATESVILLE, NC 28625

LOCATION OLD MOCKSVILLE RD, TR SOCIETY CH. RD, TR SUNFLOWER RD, 1.0 MILE ON LEFT.

SUBDIVISION BLOCK / SECTION LOT LOT AREA 38.76 Ac SITE CLASS PS DESIGN FLOW 360 L.T.A.R.

Septic Tank: 1000 Gallons; STB Date

Pump Tank: Gallons; PT Date

Pump Make: Model Serial No.

Nitrification Field: No Fields 1 Square Feet 300 Linear Feet 100

No Lines 1 Trench Width 36" Max Trench Bottom Depth 36" Gravel Depth 12"

☑ New System ☐ Repair System Type: I, (II), III, IV, V, VI

System Description: CONVENTIONAL GRAVITY

Repair System Description: CONV. GRAVITY

Maintenance Agreement Required: ☐ Yes ☑ No

☐ House/Mod. Home ☑ Mobile Home ☐ Business ☐ Other

No. Bedrooms 3 No. Bathrooms 2 No. Employees


☐ Slab ☑ Crawl Space ☐ Basement w/plumbing ☐ Basement wo/plumbing

Water Supply: ☐ Individual ☐ Public ☐ Community


Comments/Conditions: INSTALL NEW DROP BOX ON EXISTING LINE AS SHOWN FEEDING NEW 3'X100' LINE INSTALLED ON CONTOUR

Comments/Conditions:

INITIAL SITE SKETCH SCALE: 1"=40'

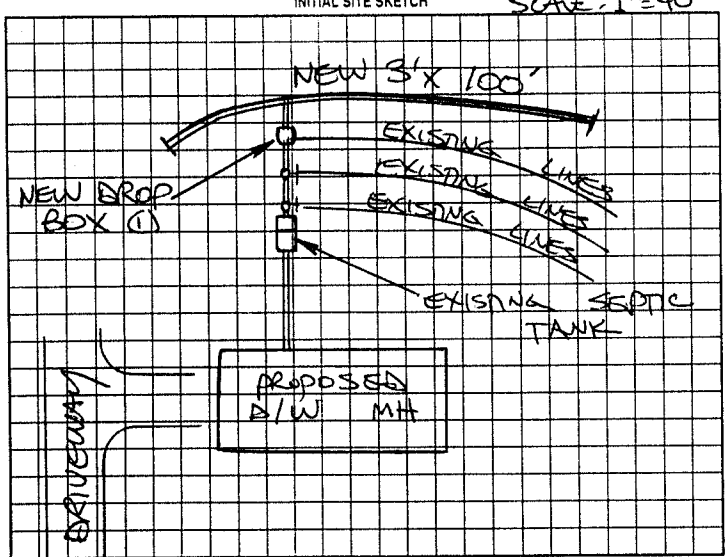

AS BUILT SKETCH

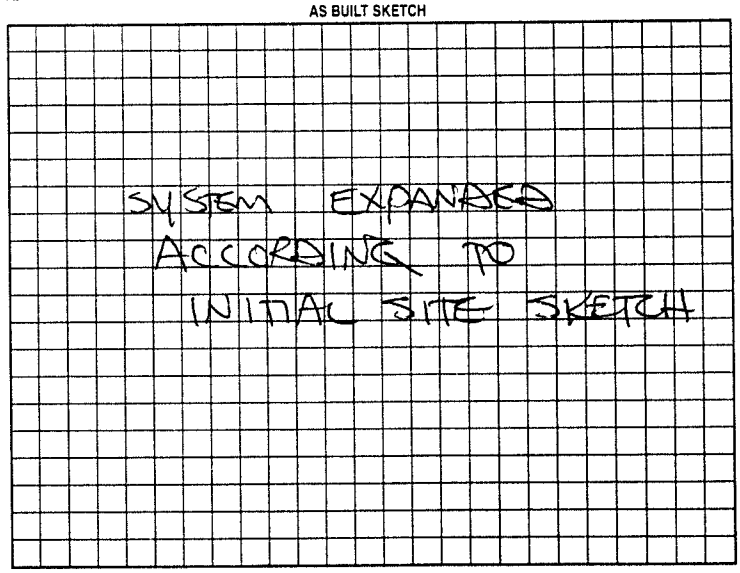

Permit can be suspended or revoked if any false information is supplied toward securing the permit/any unauthorized changes are made to the site/any unauthorized changes are made in the installation of the system. Improvement Permit with plat valid without expiration. Improvement Permit with site plan valid for sixty months. Authorization to Construct is valid for a period equal to that of Improvement Permit – not to exceed sixty months.

Signed: Phyllis Beaty date 5-17-00 Installed by: A-1 BACKHOE

Improvement Permit by: STEVE HEDRICK date 5-16-00 Operation Permit by: STEVE HEDRICK date 6-7-00

Authorization to Construct by: STEVE HEDRICK date 5-16-00 Existing System Inspection by: date

HEALTH DEPT. COPY: WHITE OWNER COPY (FINAL): YELLOW OWNER COPY (INITIAL): PINK