IREDELL COUNTY HEALTH DEPARTMENT

STATESVILLE 704-878-5305 MOORESVILLE 704-664-5281

IMPROVEMENT PERMIT / AUTHORIZATION TO CONSTRUCT / OPERATION PERMIT / EXISTING SYSTEM INSPECTION

PERMIT# 117598 PIN# 4788-90-~~6838~~ 4373 DATE 1-6-04

OWNER OR CONTRACTOR Fleetwood Homes of Statesville PHONE: Business 704-400-7019 Home

ADDRESS 1270 Northside Dr. Statesville 28677

LOCATION [redacted] Old Mocksville Rd (R) Society (R) Sunflower 1.0 mile on left

SUBDIVISION BLOCK / SECTION LOT LOT AREA 38.76 SITE CLASS. PS DESIGN FLOW 360 L.T.A.R. —

Septic Tank: EXIST Gallons; STB Date

Pump Tank: Gallons; PT Date

Pump Make: Model Serial No.

Nitrification Field: No Fields 1 Square Feet E 1200 Linear Feet 400

No Lines 4 Trench Width 36" Max Trench Bottom Depth 36" Gravel Depth 12

☐ New System ☐ Repair System Type: I, (II), III, IV, V, VI

System Description: Conv. Gravity

Repair System Description: Conv. Gravity

Maintenance Agreement Required: ☐ Yes ☑ No

☐ House/Mod. Home No. Bedrooms 3

☑ Mobile Home No. Bathrooms 2

☐ Business No. Employees

☐ Other

☐ Slab ☑ Crawl Space ☐ Basement w/plumbing ☐ Basement wo/plumbing


Water Supply: ☑ Individual ☐ Public ☐ Community WELL

Comments:/Conditions:

Comments:/Conditions: ① System sized for 3-bedroom home. ② Functioning properly at time of visit ③ New home shall not increase number of bedrooms on system ④ Existing system inspection only. Does not guarantee life of system for future use.

INITIAL SITE SKETCH

AS BUILT SKETCH 1"=40' SCALE

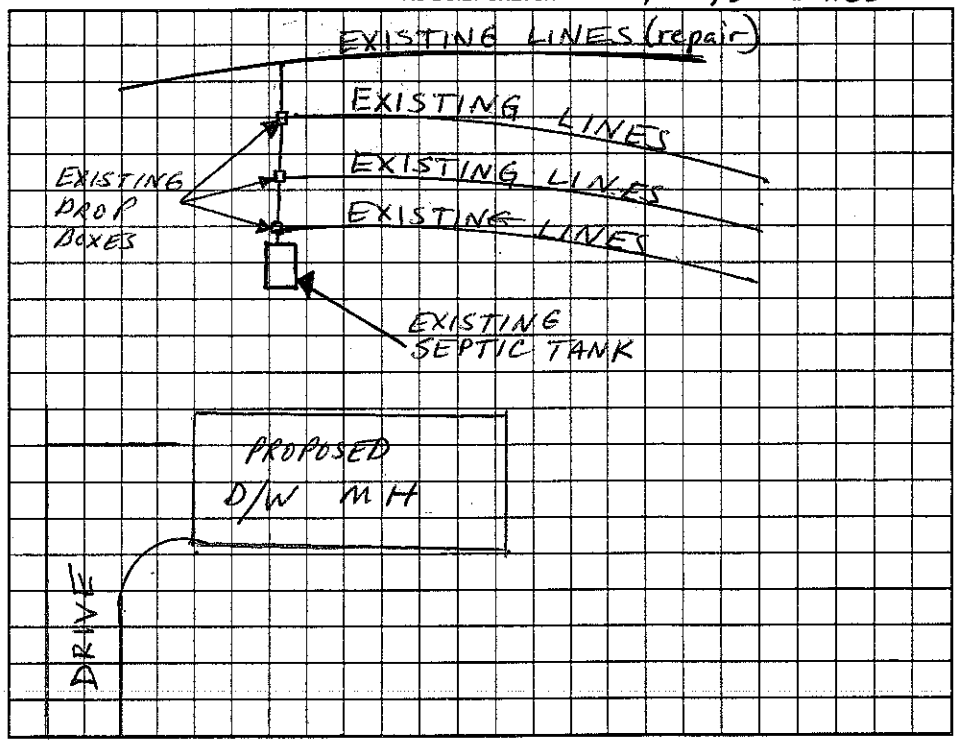

Permit can be suspended or revoked if any false information is supplied toward securing the permit/any unauthorized changes are made to the site/any unauthorized changes are made in the installation of the system. Improvement Permit with plat valid without expiration. Improvement Permit with site plan valid for sixty months. Authorization to Construct is valid for a period equal to that of Improvement Permit – not to exceed sixty months.

Signed: date

Improvement Permit by: date

Authorization to Construct by: date

Installed by:

Operation Permit by: date

Existing System Inspection by: Christopher M. Merrill date 1/6/04

HEALTH DEPT. COPY: WHITE OWNER COPY (FINAL): YELLOW OWNER COPY (INITIAL): PINK