IREDELL COUNTY HEALTH DEPARTMENT

STATESVILLE 704-878-5305 MOORESVILLE 704-664-5281

IMPROVEMENT PERMIT / CERTIFICATE OF COMPLETION / OPERATION PERMIT / EXISTING SYSTEM INSPECTION

PROPERTY DESCRIPTION NO. 21818 DATE 8-16-95 TAX MAP NO. 12C-A-12A (PART) Watershed: ☐ Yes ☑ No

OWNER OR CONTRACTOR MIKE GRUBER PHONE: Business Home 546-5787

ADDRESS 593 VAUGHN MILL ROAD, STATESVILLE, NC 28677

LOCATION OLD MOCKSVILLE RD NE, TR SOCIETY CH RD, TR VAUGHN MILL RD, 1ST MH ON (R)

SUBDIVISION BLOCK / SECTION LOT LOT AREA 1.41 AC SITE CLASS PS DESIGN FLOW 240 L.T.A.R. 0.33

Septic Tank: 1000 Gallons; STB Date

Pump Tank: Gallons; PT Date

Pump Make: Model Serial No.

Nitrification Field: No Fields 1 Square Feet 720 Linear Feet 240

No Lines 2 Trench Width Max Trench Bottom Depth Gravel Depth

☐ New System ☐ Repair System Type: I, II, III, IV, V, VI

System Description: CONV. GRAVITY

Repair System Description:

Maintenance Agreement Required: ☐ Yes ☑ No

☐ Slab ☑ Crawl Space ☐ Basement w/plumbing ☐ Basement wo/plumbing

☐ House/Mod Home No. Bedrooms 2

☑ Mobile Home No. Bathrooms 1

☐ Business No. Employees

☐ Other


Water Supply: ☑ Individual ☐ Community ☐ Public WELL

Comments:

Comments: KEEP MH MINIMUM 5' FROM SYSTEM

INITIAL SITE SKETCH

AS BUILT SKETCH

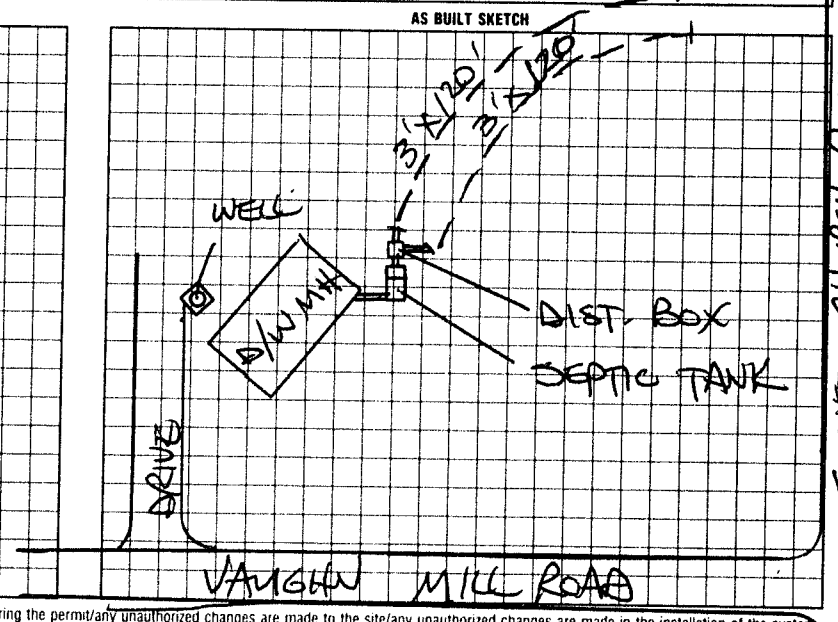

I understand that this permit can be suspended or revoked if any false information is supplied toward securing the permit/any unauthorized changes are made to the site/any unauthorized changes are made in the installation of the system.

Signed: Installed by

Improvement Permit by: date Certificate of Completion by date

Existing System Inspection by: STEVE HENDRICK date 8-16-95 Operation Permit by date

HEALTH DEPT. COPY: WHITE INSPECTION COPY (FINAL): GREEN OWNER COPY (FINAL): YELLOW INSPECTION COPY (INITIAL): PINK OWNER COPY (INITIAL): GOLD