IREDELL COUNTY HEALTH DEPARTMENT

THIS PERMIT VOIDS PREVIOUS ISSUED 3/17/95

STATESVILLE 704-878-5305 MOORESVILLE 704-664-3281

IMPROVEMENT PERMIT / CERTIFICATE OF COMPLETION / OPERATION PERMIT / EXISTING SYSTEM INSPECTION

PROPERTY DESCRIPTION NO 20498 DATE 4/4/95 TAX MAP NO 12C-A-12A (PART OF) Watershed: [ ] Yes [X] No

OWNER OR CONTRACTOR PAUL GRYDER PHONE: Business _____ Home 546-7774

ADDRESS RT-4, BOX 247 C STATESVILLE NC 28677

LOCATION OLD MOCKSVILLE RD NB, TR SOCIETY CH. RD, MH on RS RIGHT AT VAUGHN MILL RD (LT)

SUBDIVISION _____ BLOCK / SECTION _____ LOT _____ LOT AREA _____ SITE CLASS _____ DESIGN FLOW 360 L.T.A.R. 0.35 AR/LT

Septic Tank 1000 Gallons; STB 6020 Date 3/27/95 | [X] New System [ ] Repair System Type: I, II, IV, V | [ ] House/Mod. Home No. Bedrooms 3 | Water Supply: [X] Individual

Pump Tank _____ Gallons; FT _____ Date _____ | System Description CONVENTIONAL GRAVITY | [X] Mobile Home No. Bathrooms 1 | [ ] Community

Pump Make _____ Model _____ Serial No _____ | Repair System Description CONV. GRAVITY | [ ] Business No. Employees _____ | [ ] Public WELL


Nitrification Field: No Fields 1 Square Feet 1035 Linear Feet 345 | Maintenance Agreement Required: [ ] Yes [X] No | [ ] Other _____

No Lines 3 Trench Width 36 Max Trench Bottom Depth 18-36 Gravel Depth 12 | [ ] Slab [ ] Crawl Space [ ] Basement w/plumbing [ ] Basement w/o plumbing

Comments: KEEP SYSTEM MINIMUM 5' FROM MH, 10' FROM PROPERTY LINE, 100' FROM WELL

Comments:

INITIAL SITE SKETCH

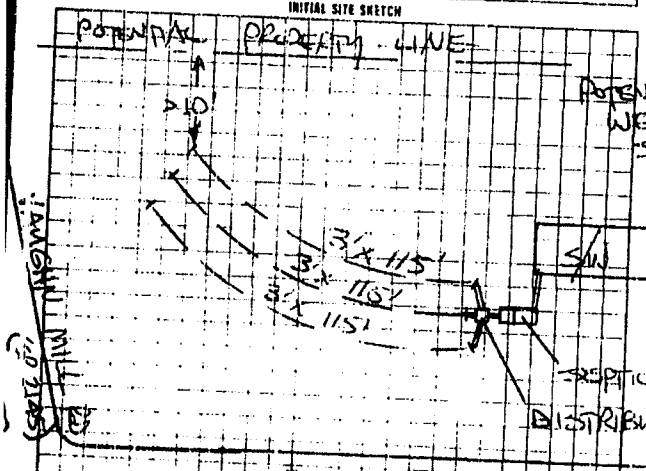

AS BUILT SKETCH

SYSTEM INSTALLED ACCORDING TO INITIAL SITE SKETCH

Upon the issuance of a permit, it can be suspended or revoked if any of the information is supplied toward securing the permit is untrue or if any unauthorized changes are made to the site or any unauthorized changes are made in the installation of the system.

Improvement Permit is valid for 60 months from date of issuance

Signed Paul K Gryder

Improvement Permit by STEVE HENDRICK date 4/4/95

Installed by SAMMY REAVIS

Certificate of Completion by STEVE HENDRICK date 4/26/95

Operation Permit by _____ date _____

APPLICANT COPY (FINAL) YELLOW INSPECTION COPY (INITIAL) PINK OWNER COPY (INITIAL) GOLD

JAN. 3, 1989 3:13