IREDELL COUNTY HEALTH DEPARTMENT

STATESVILLE 704-878-5305 MOORESVILLE 704-664-5281

IMPROVEMENT PERMIT / AUTHORIZATION TO CONSTRUCT / OPERATION PERMIT / EXISTING SYSTEM INSPECTION

PERMIT# 82745 PIN# 4788967765 DATE 7-21-99

OWNER OR CONTRACTOR Grant Dively PHONE: Business Home 704 435 1661

ADDRESS

LOCATION 405 W Carroll St Cherryville NC. LHE To Society Church Rd 1.25 miles on left

SUBDIVISION BLOCK / SECTION LOT LOT AREA 1.35 acre SITE CLASS PS DESIGN FLOW 360 L.T.A.R .3

Septic Tank: 1000 Gallons; STB 760 Date 5-14-99

Pump Tank: Gallons; PT Date

Pump Make: Model Serial No.

Nitrification Field: No Fields 1 Square Feet 810 Linear Feet 270

No Lines 4 Trench Width 36" Max Trench Bottom Depth 36" Gravel Depth 12"

☑ New System ☐ Repair System Type: I II III IV V VI

System Description: Conv. Gravity

Repair System Description Gravity 25% Red

Maintenance Agreement Required: ☐ Yes ☑ No

☐ House/Mod. Home ☑ Mobile Home ☐ Business ☐ Other

No. Bedrooms 2 No. Bathrooms 2 No. Employees


Water Supply: ☑ Individual ☐ Public ☐ Community

☐ Slab ☑ Crawl Space ☐ Basement w/plumbing ☐ Basement wo/plumbing

Comments/Conditions:


Society Road

INITIAL SITE SKETCH

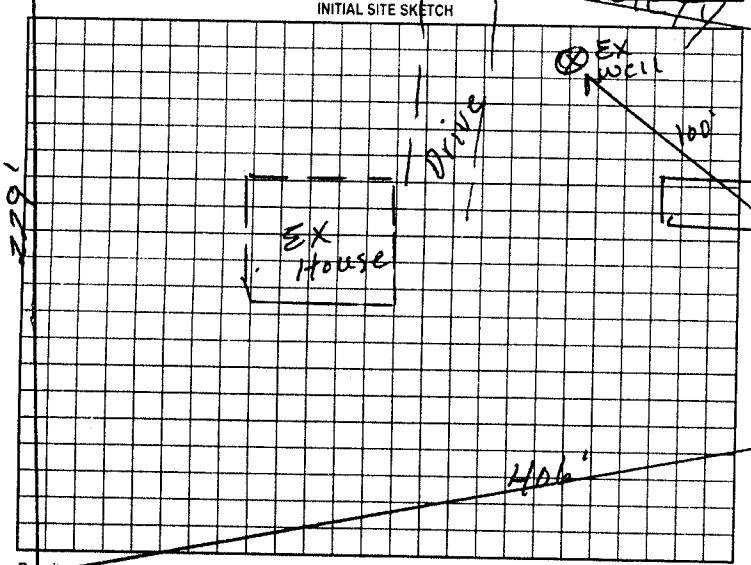

Comments/Conditions

AS BUILT SKETCH

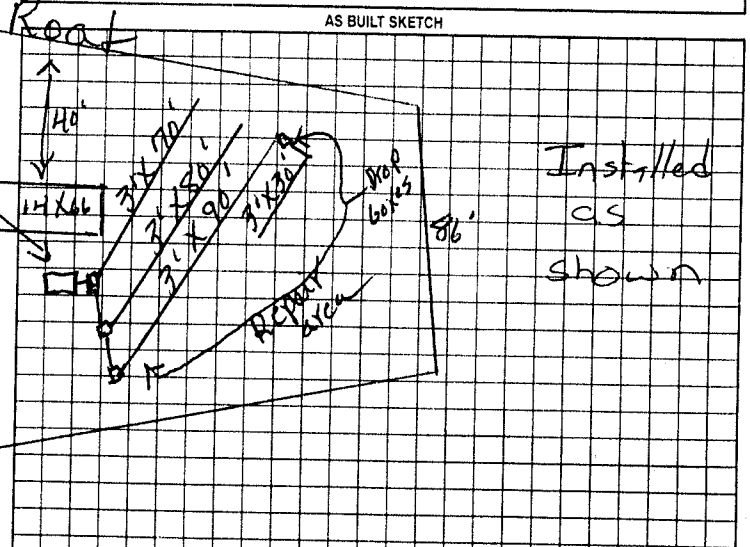

Installed as shown

Permit can be suspended or revoked if any false information is supplied toward securing the permit/any unauthorized changes are made to the site/any unauthorized changes are made in the installation of the system. Improvement Permit with plat valid without expiration. Improvement Permit with site plan valid for sixty months. Authorization to Construct is valid for a period equal to that of Improvement Permit – not to exceed sixty months.

Signed: Grant W. Dively date Installed by: Berry Sigmon

Improvement Permit by: P.C. Moore date 7-21-99 Operation Permit by: Mat Coffey RS date 8-11-99

Authorization to Construct by: P.C. Moore date 7-21-99 Existing System Inspection by: date

HEALTH DEPT. COPY: WHITE OWNER COPY (FINAL) YELLOW OWNER COPY (INITIAL) PINK