IREDELL COUNTY HEALTH DEPARTMENT

STATESVILLE 704-878-5305 MOORESVILLE 704-664-5281

IMPROVEMENT PERMIT / AUTHORIZATION TO CONSTRUCT / OPERATION PERMIT / EXISTING SYSTEM INSPECTION

RSH

PERMIT # 158656 PIN # 4789025446 DATE 11-23-09

OWNER or APPLICANT Zitlali Torres (owner) Gilberto Gonzalas PHONE: Business Home: 704-546-5833

OWNER or APPLICANT ADDRESS 105 Hardluck Hill Lane Harmony NC 28634

LOCATION / DIRECTIONS 21W (R) Mt Bethel RD (L) Rimrock (L) Hard Luck Lane


SUBDIVISION BLOCK / SECTION LOT # ~~6AC~~ LOT AREA 6AC DESIGN FLOW ~~480~~ 360 L.T.A.R. .25

Septic Tank 1000 Gallons: STB 760	Date 3.12-10	☑ New System ☐ Repair ☐ Expansion System Type I II (III) IV V VI	☑ Residence No. Bedrooms ~~4~~ 3
Pump Tank Gallons: PT	Date	System Description: 25% Gravity	☐ Business No. Persons
Pump Make Model	Serial #	Repair System Description: 50% Low Pres	☐ Other No. Employees
Nitrification Field No Fields 1 No Lines 5	Linear Feet 480	Maintenance Agreement Required ☐ YES ☑ NO	☐ Slab ☑ Crawl Space
Trench Width 36" Max. Trench Bottom Depth 36"	Gravel Depth NA	☑ GRAVITY ☐ PRESSURE	☐ Basement w/plumbing ☐ Basement w/o plumbing

Water Supply: ☐ Private ☑ Public ☐ Community

Comments / Conditions

INITIAL SITE SKETCH

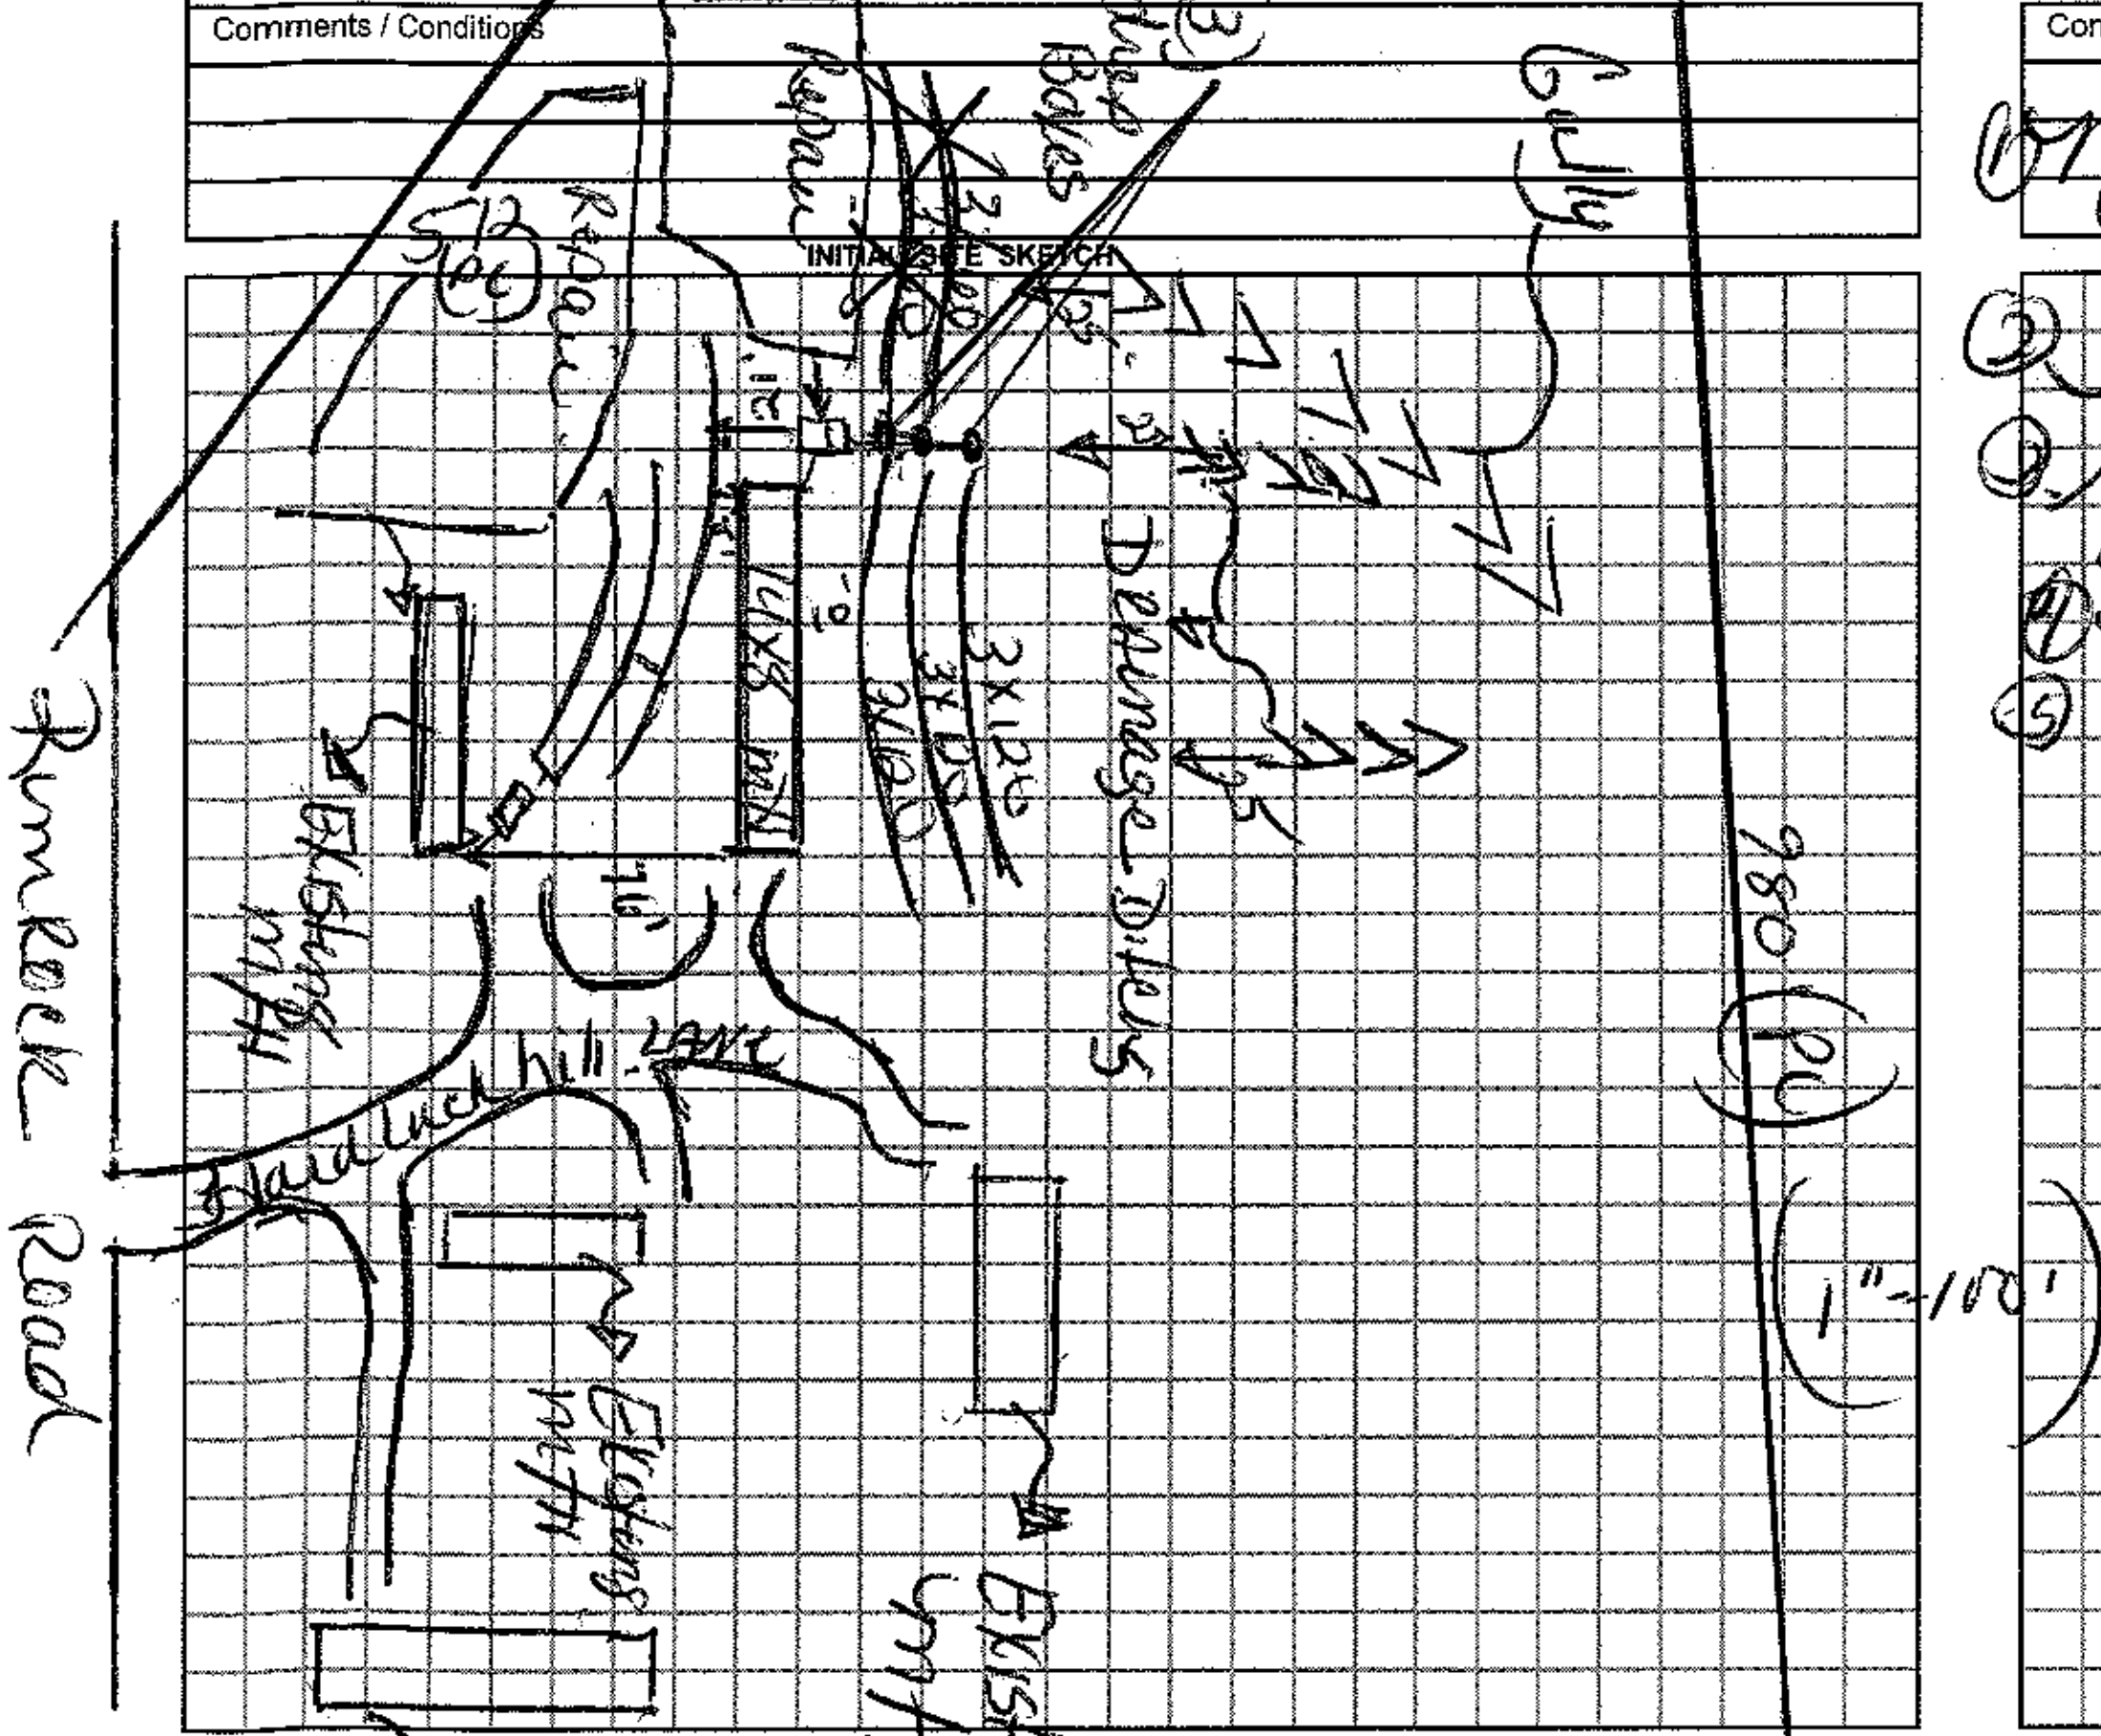

Comments / Conditions

(1) Maintain 25' upslope of Gully's and drainage ditches

AS BUILT SKETCH

(2) Trailer must be 8' off Septic line of trailer in front of it.
(3) New system must be 20' off existing system
(4) maintain all setback
(5) Install on Contour

(3) 120'

3BR

Permit can be suspended or revoked if any false information is supplied toward securing the permit / any unauthorized changes are made to the site / any unauthorized changes are made in the installation of the system.

☐ *IMPROVEMENT PERMIT w / plat valid without expiration.* ☑ *IMPROVEMENT PERMIT w / site plan valid for 60 mos.* ☑ *AUTHORIZATION TO CONSTRUCT valid for period equal to IMPROVEMENT PERMIT-not to exceed 60 mo.*

Owner / Applicant Signature: Zitlali Torres Date 11-25-09

Improvement Permit by: [signature] Date 11-23-09

Authorization to Construct by: [signature] Date 11-23-09

Installed by: A-J Backhoe

Operation Permit by: [signature] Date: 8-2-10

Existing System Inspected by: Date:

YOU SHOULD CONTACT A LOCATOR SERVICE PRIOR TO ANY EXCAVATION.

WHITE COPY Environmental Health YELLOW COPY (Final) Owner / Applicant PINK COPY (Initial) Owner / Applicant