IREDELL COUNTY HEALTH DEPARTMENT

STATESVILLE 704-878-5305 MOORESVILLE 704-664-5281

IMPROVEMENT PERMIT / AUTHORIZATION TO CONSTRUCT / OPERATION PERMIT / EXISTING SYSTEM INSPECTION

PERMIT# 081449 PIN# 4789 02 5461 DATE 5-27-99

OWNER OR CONTRACTOR TIMOTHY ABEE PHONE: Business , Home (336) 492-2089

ADDRESS 134 POWELL ROAD, MOCKSVILLE, NC 27028

LOCATION US 21 N, TR MT. BETHEL, TL RIMROCK, TL HARD LUCK HILL LANE, MH LOT ON RIGHT

SUBDIVISION BLOCK / SECTION LOT LOT AREA 0.50 ACRE SITE CLASS PS DESIGN FLOW 360 L.T.A.R. 0.30 GPD/FT²

Septic Tank: 1000 Gallons; STB 1012 Date 8-17-99

Pump Tank: Gallons; PT Date

Pump Make: Model Serial No.

Nitrification Field: No Fields 1 Square Feet ~~EST~~ 1200 Linear Feet 300+

No Lines FIVE Trench Width 36" Max Trench Bottom Depth 36" ~~Gravel~~ Depth SAND 6"

☑ New System ☐ Repair System Type: I. II. III. IV. V. VI

System Description: 25% REDUCTION GRAVITY

Repair System Description: 50% REDUCTION GRAVITY

Maintenance Agreement Required: ☐ Yes ☑ No

☐ House/Mod. Home ☑ Mobile Home ☐ Business ☐ Other

No. Bedrooms 3 No. Bathrooms 2 No. Employees


☐ Slab ☑ Crawl Space ☐ Basement w/plumbing ☐ Basement wo/plumbing

Water Supply: ☑ Individual ☐ Public ☐ Community WELL

Comments/Conditions ① NO VEHICULAR TRAFFIC ALLOWED OVER SYSTEM ② INSTALL 25% REDUCTION SYSTEM USING FIFTY (50) CHAMBERS OR THIRTY (30) HDS SECTIONS AS FLAGGED ON SITE

Comments/Conditions SEPTIC TANK W/ RISERS INSTALLED USING "POLYLOK" FILTER

INITIAL SITE SKETCH SCALE: 1" = 40'

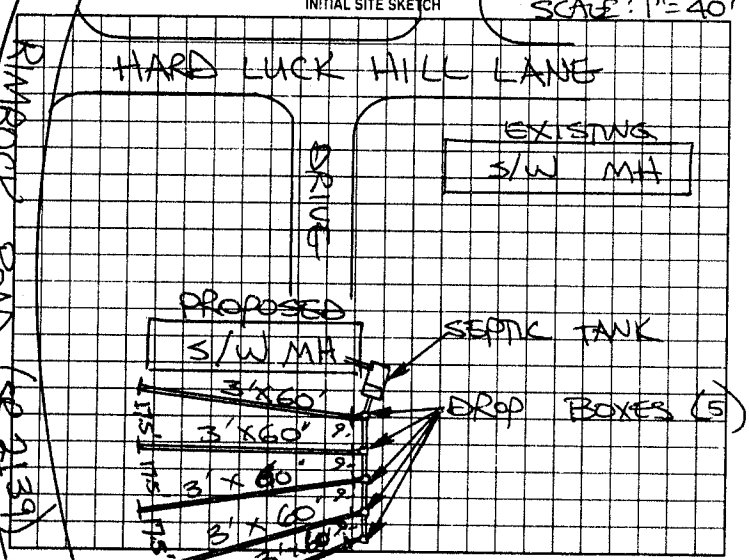

AS BUILT SKETCH

SYSTEM INSTALLED ACCORDING TO INITIAL SITE SKETCH

Permit can be suspended or revoked if any false information is supplied toward securing the permit/any unauthorized changes are made to the site/any unauthorized changes are made in the installation of the system. Improvement Permit with plat valid without expiration. Improvement Permit with site plan valid for sixty months. Authorization to Construct is valid for a period equal to that of Improvement Permit – not to exceed sixty months.

Signed: Duval Abee date 5/27/99 Installed by: STEVE JORDAN

Improvement Permit by: STEVE HEDRICK date 5-27-99 Operation Permit by: STEVE HEDRICK date 11-8-99

Authorization to Construct by: STEVE HEDRICK date 5-27-99 Existing System Inspection by: date

REPAIR

HEALTH DEPT. COPY: WHITE OWNER COPY (FINAL): YELLOW OWNER COPY (INITIAL): PINK