ROGER TEMPLETON

IREDELL COUNTY HEALTH DEPARTMENT

STATESVILLE 704-878-5305 MOORESVILLE 704-664-5281

IMPROVEMENT PERMIT / AUTHORIZATION TO CONSTRUCT / OPERATION PERMIT / EXISTING SYSTEM INSPECTION

PERMIT# 073084 PIN# 4789 03 9046 DATE 4-23-98

OWNER OR CONTRACTOR LEON BARKER PHONE: Business Home 873-1014

ADDRESS 2920 HARMONY HWY (LEON BARKER), HARMONY, NC 28634

LOCATION US21N, TR MT. BETHEL, TL SHAW ROAD, 4½ LOT ON RIGHT

SUBDIVISION RIMROCK EST. BLOCK / SECTION LOT 13 LOT AREA 0.672 ACRE SITE CLASS PS DESIGN FLOW 360 L.T.A.R. 0.33GPD/FT²

Septic Tank: 1000 Gallons; STB 620 Date 10-12-97
Pump Tank: Gallons; PT Date
Pump Make: Model Serial No.
Nitrification Field: No Fields 1 Square Feet 1080 Linear Feet 360
No Lines FIVE Trench Width 36" Max Trench Bottom Depth 36" Gravel Depth 12"

☑ New System ☐ Repair System Type: I, II, III, IV, V, VI
System Description: CONVENTIONAL GRAVITY
Repair System Description: CONV. GRAVITY
Maintenance Agreement Required: ☐ Yes ☑ No

☐ House/Mod. Home ☑ Mobile Home ☐ Business ☐ Other
No. Bedrooms 3 No. Bathrooms 2 No. Employees


☐ Slab ☑ Crawl Space ☐ Basement w/plumbing ☐ Basement wo/plumbing

Water Supply: ☐ Individual ☐ Public ☐ Community


Comments:/Conditions:

Comments:/Conditions:

INITIAL SITE SKETCH SCALE: 1"=40'

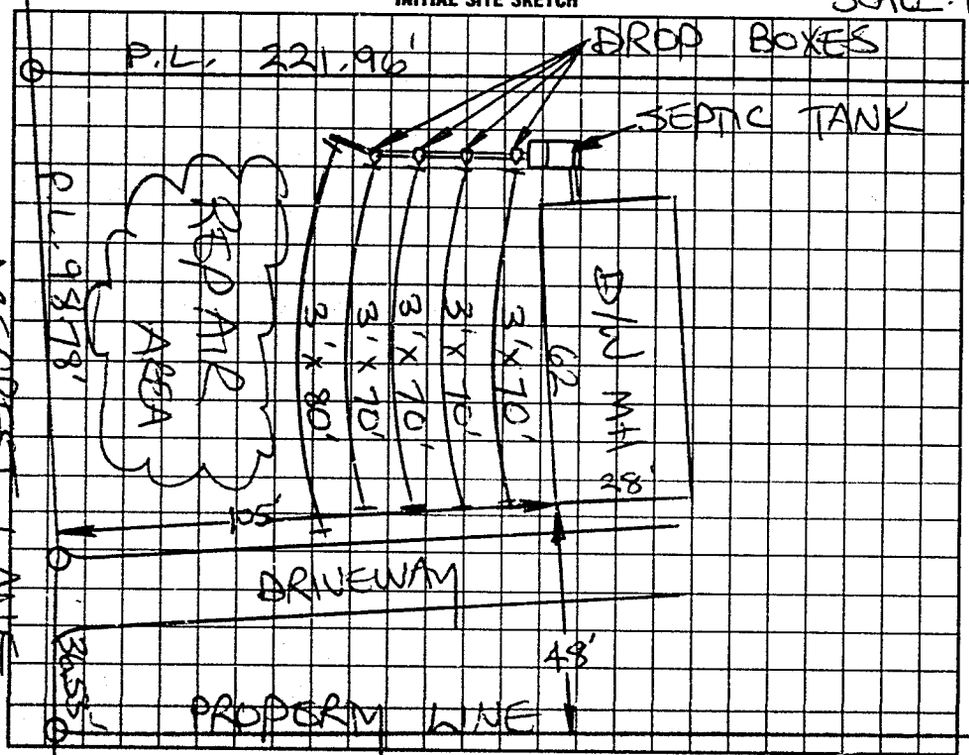

AS BUILT SKETCH

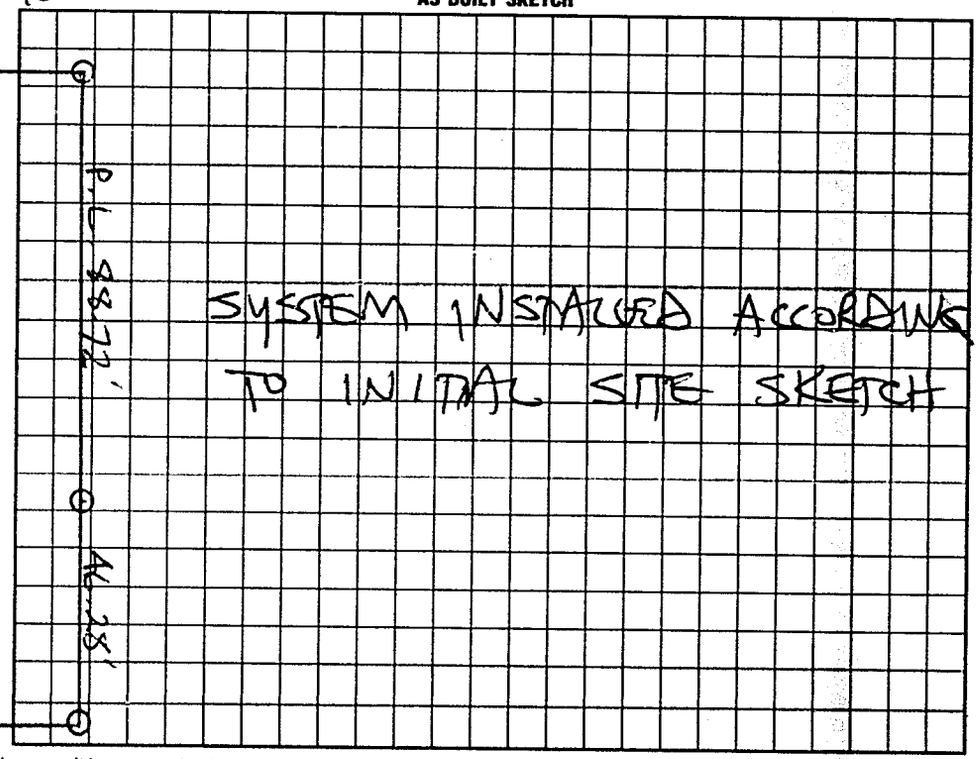

I understand that this permit can be suspended or revoked if any false information is supplied toward securing the permit/any unauthorized changes are made to the site/any unauthorized changes are made in the installation of the system. Improvement Permit with plat valid without expiration. Improvement Permit with site plan valid for sixty months. Authorization to Construct is valid for a period equal to that of Improvement Permit – not to exceed sixty months.

Signed: Roger Templeton date 4-23-98 Installed by: SAMMY REAVIS

Improvement Permit by: STEVE HEDRICK date 4-23-98

Authorization to Construct by: STEVE HEDRICK date 4-23-98 Operation Permit by: ~~Existing System Inspection by:~~ STEVE HEDRICK date 5-21-98

HEALTH DEPT. COPY: WHITE INSPECTION COPY (FINAL): GREEN OWNER COPY (FINAL): YELLOW INSPECTION COPY (INITIAL): PINK OWNER COPY (INITIAL): GOLD