IREDELL COUNTY HEALTH DEPARTMENT

STATESVILLE 704-878-5305 MOORESVILLE 704-664-5281

IMPROVEMENT PERMIT / CERTIFICATE OF COMPLETION / OPERATION PERMIT / EXISTING SYSTEM INSPECTION

PROPERTY DESCRIPTION NO. 21336 DATE 6/12/95 TAX MAP NO. 12 J- A- 90

OWNER OR CONTRACTOR ERIC D. ANDERSON PHONE: Business Watershed: ☐ Yes ☑ No

ADDRESS 178 CRANFILL ROAD, HARMONY NC 28634 Home (910) 468-2905

LOCATION 4521 N, TR NC 901, TR CRANFILL ROAD, ON LEFT AT PAVEMENT END

SUBDIVISION BLOCK / SECTION LOT LOT AREA 1.54 AC. SITE CLASS. PS DESIGN FLOW 360 L.T.A.R. 0.35 GPD/FT²

Septic Tank: 1000 Gallons; STB 620 Date 4-20-95

Pump Tank: Gallons; PT Date

Pump Make: Model Serial No.

Nitrification Field: No Fields 1 Square Feet 1035 Linear Feet 345

No Lines 3 Trench Width 36 Max Trench Bottom Depth 18-30" Gravel Depth 12"

☑ New System ☐ Repair System Type: I, II, III, IV, V, VI

System Description: CONVENTIONAL GRAVITY

Repair System Description: CONV. GRAVITY

Maintenance Agreement Required: ☐ Yes ☑ No

☐ House/Mod. Home ☑ Mobile Home ☐ Business ☐ Other

No. Bedrooms 3 No. Bathrooms 2 No. Employees


☐ Slab ☑ Crawl Space ☐ Basement w/plumbing ☐ Basement wo/plumbing

Water Supply: ☐ Individual ☐ Community ☑ Public

Comments: ① KEEP SYSTEM MINIMUM 5' FROM MH 10' FROM PROPERTY LINE ② INSTALL LINES MINIMUM 9' APART ON CENTER NO DEEPER THAN 36"

Comments:

INITIAL SITE SKETCH

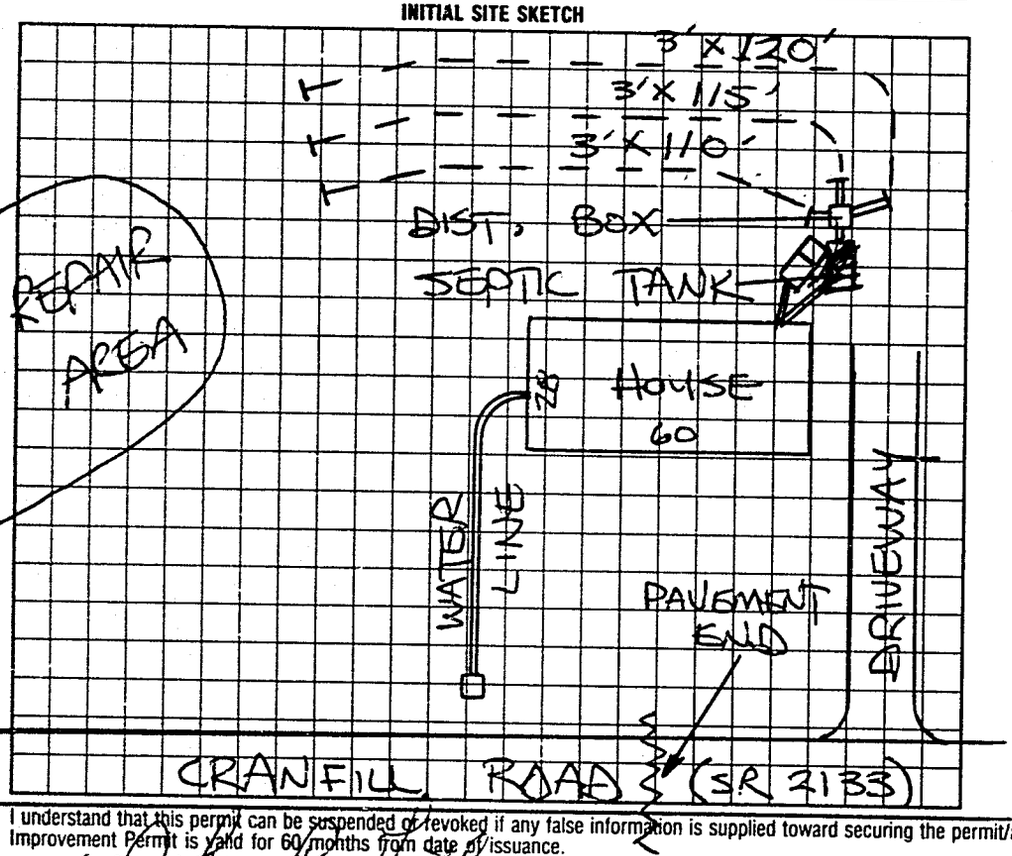

AS BUILT SKETCH

SYSTEM INSTALLED ACCORDING TO INITIAL SITE SKETCH

I understand that this permit can be suspended or revoked if any false information is supplied toward securing the permit/any unauthorized changes are made to the site/any unauthorized changes are made in the installation of the system. Improvement Permit is valid for 60 months from date of issuance.

Signed: x Justin K. Hatley

Improvement Permit by: STEVE HEDRICK date 6/12/95

Existing System Inspection by: date

Installed by: SAMMY REAVIS

Certificate of Completion by: STEVE HEDRICK date 7-3-95

Operation Permit by: date

HEALTH DEPT. COPY: WHITE INSPECTION COPY (FINAL): GREEN OWNER COPY (FINAL): YELLOW INSPECTION COPY (INITIAL): PINK OWNER COPY (INITIAL): GOLD

6 9 8 4