IREDELL COUNTY HEALTH DEPARTMENT

THIS PERMIT VOIDS PREVIOUS ISSUED 7-14-98

STATESVILLE 704-878-5305 MOORESVILLE 704-664-5281

IMPROVEMENT PERMIT / AUTHORIZATION TO CONSTRUCT / OPERATION PERMIT / EXISTING SYSTEM INSPECTION

PERMIT# 074763 PIN# 4789 12 0286 DATE 8-4-98

OWNER OR CONTRACTOR CASEY & DANETTE JONES PHONE: Business Home 576-8500

ADDRESS 354 RIMROCK ROAD HARMONY NC 28634

LOCATION U.S 21 N, TR MT. BETHEL ROAD, TL RIMROCK ROAD, 2ND & 3RD LOTS ON LEFT BEFORE SHAW ROAD

SUBDIVISION RIMROCK EST BLOCK / SECTION LOT 28-29 LOT AREA 2.44 ACRES SITE CLASS. PS DESIGN FLOW 360 L.T.A.R. 0.30 SQ FT

Septic Tank: 1000 Gallons; STB 620 Date 6-20-98

Pump Tank: Gallons; PT Date

Pump Make: Model Serial No.

Nitrification Field: No Fields 1 Square Feet EQ. TO 1200 Linear Feet 300+

No Lines FOUR Trench Width 36" Max Trench Bottom Depth 36" Gravel Depth SAND 6"

☑ New System ☐ Repair System Type: I, II, III, IV, V, VI

System Description: 25% REDUCTION CRAWL

Repair System Description: CONVENTIONAL PUMP

Maintenance Agreement Required: ☐ Yes ☑ No

☐ House/Mod. Home ☑ Mobile Home ☐ Business ☐ Other

No. Bedrooms 3 No. Bathrooms 2 No. Employees


☐ Slab ☑ Crawl Space ☐ Basement w/plumbing ☐ Basement wo/plumbing

Water Supply: ☑ Individual ☐ Public ☐ Community WELL


Comments:/Conditions: INSTALL 25% REDUCTION SYSTEM USING FIFTY CHAMBERS OR THIRTY HDS SECTIONS AS FLAGGED

Comments:/Conditions:

INITIAL SITE SKETCH

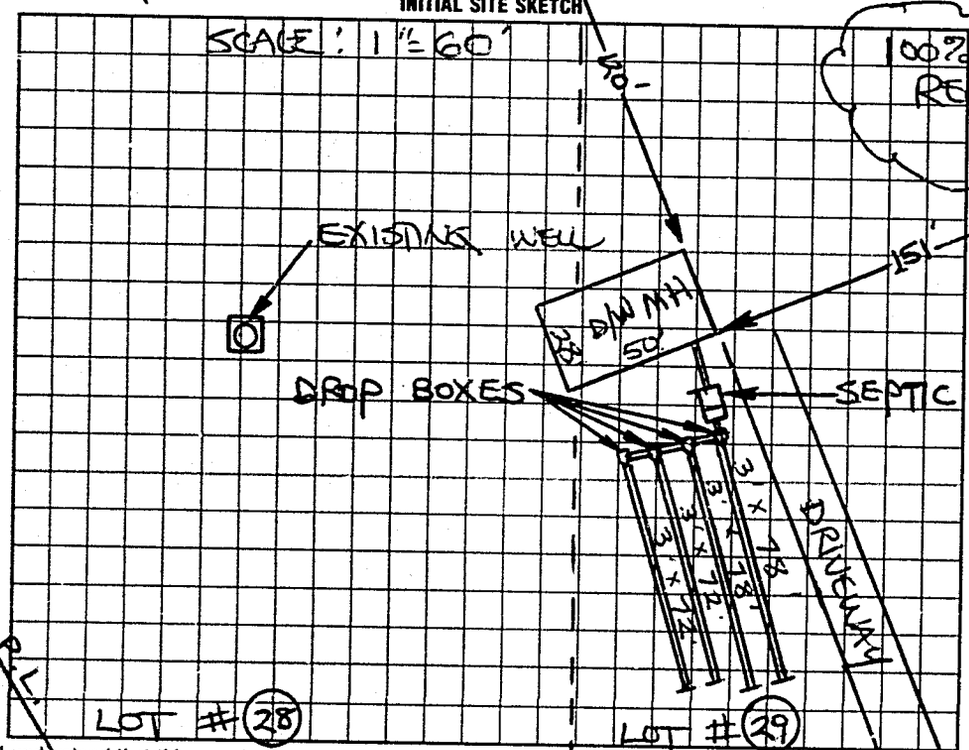

AS BUILT SKETCH

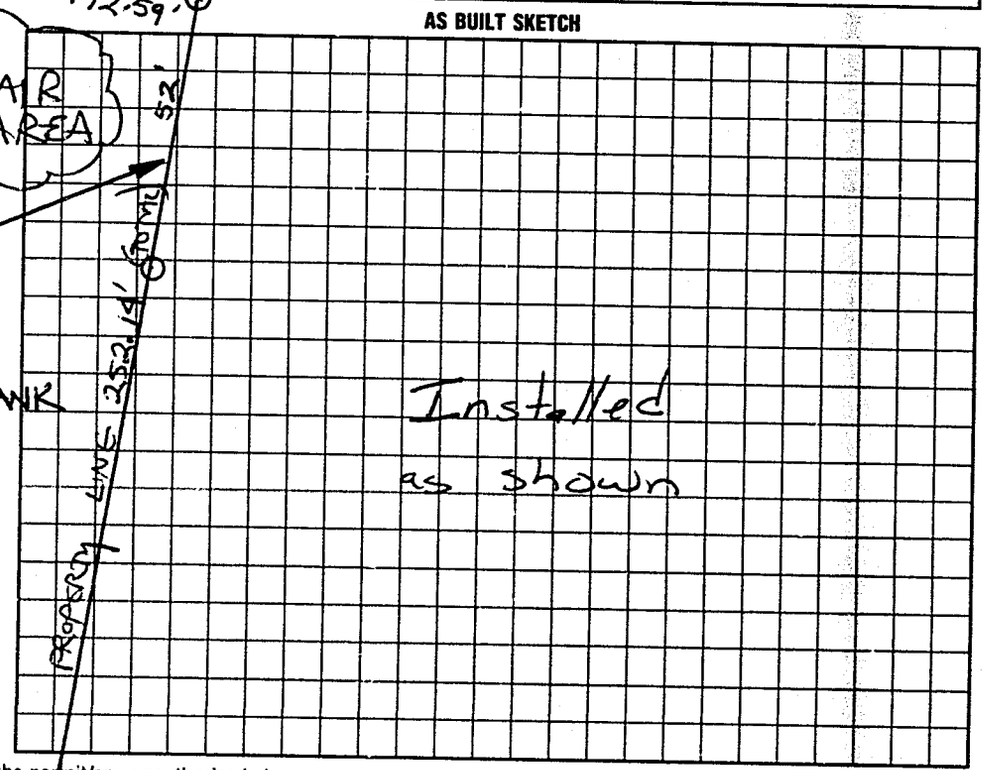

I understand that this permit can be suspended or revoked if any false information is supplied toward securing the permit/any unauthorized changes are made to the site/any unauthorized changes are made in the installation of the system. Improvement Permit with plat valid without expiration. Improvement Permit with site plan valid for sixty months. Authorization to Construct is valid for a period equal to that of Improvement Permit – not to exceed sixty months.

Signed: x Casey C. Jones date 8-4-98 installed by: Keith Pate

Improvement Permit by: STEVE HEDRICK date 8-4-98 Operation Permit by: Mat Cox date 8-7-98

Authorization to Construct by: STEVE HEDRICK date 8-4-98 Existing System Inspection by: date

HEALTH DEPT COPY WHITE INSPECTION COPY (FINAL) GREEN OWNER COPY (FINAL) YELLOW INSPECTION COPY (INITIAL): PINK OWNER COPY (INITIAL): GOLD

9 2 2 2 0 0