(1:00 - 1:30)

IREDELL COUNTY HEALTH DEPARTMENT

STATESVILLE 704-878-5305 MOORESVILLE 704-664-5281

IMPROVEMENT PERMIT / AUTHORIZATION TO CONSTRUCT / OPERATION PERMIT / EXISTING SYSTEM INSPECTION

PERMIT# 079006 PIN# 4789 12 0582 DATE 2-5-99

OWNER OR CONTRACTOR BRENT MURDOCK PHONE: Business Home 528-6969

ADDRESS 368 OLD MOUNTAIN ROAD STATESVILLE NC 28677

LOCATION US 21, TR MT. BETHEL RD, TL SHAW ROAD, TR STAGECREST, LOT ON LEFT (2ND)

SUBDIVISION RIMROCK EST. BLOCK / SECTION LOT 27 LOT AREA 1.020 ACRES SITE CLASS PS DESIGN FLOW 480 L.T.A.R. 0.33 480/FT²

Septic Tank: 1000 Gallons; STB 794 Date 4-4-00
Pump Tank: Gallons; PT Date
Pump Make: Model Serial No
Nitrification Field: No. Fields 1 Square Feet 1440 Linear Feet 480
No. Lines 3 IX Trench Width 36" Max Trench Bottom Depth 36"

✓ New System Repair System Type: I II III IV V VI
System Description: CONVENTIONAL GRAVITY
Repair System Description: 25% REDUCTION PUMP
Maintenance Agreement Required: Yes ✓ No

House/Mod. Home No. Bedrooms 4
Mobile Home No. Bathrooms 2
Business No. Employees
Other


Gravel Depth 12" Slab ✓ Crawl Space Basement w/plumbing Basement wo/plumbing

Water Supply: ☐ Individual ✓ Public ☐ Community


Comments/Conditions: NO ~~X~~ FILTER INSTALLED

Comments/Conditions: Lines inspected by Brady Freeman
X (EVERYTHING CHECKED BUT FILTER) X
2 Label Filter used - 5-31

INITIAL SITE SKETCH SCALE: 1"=50'

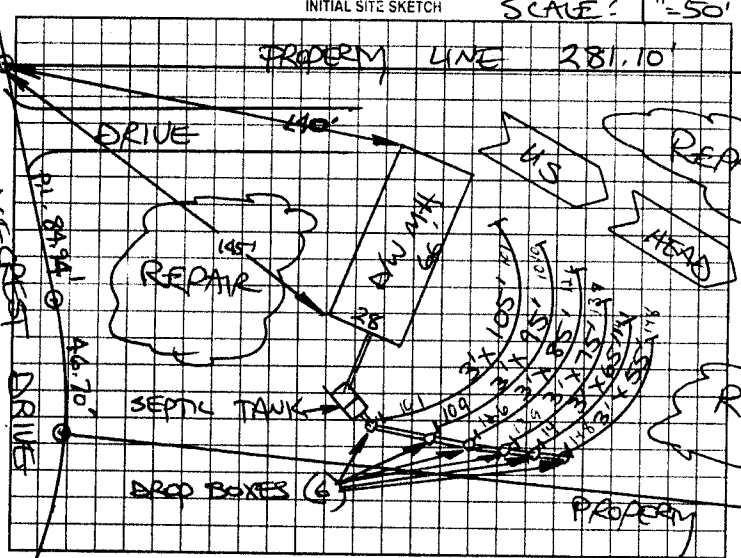

AS BUILT SKETCH

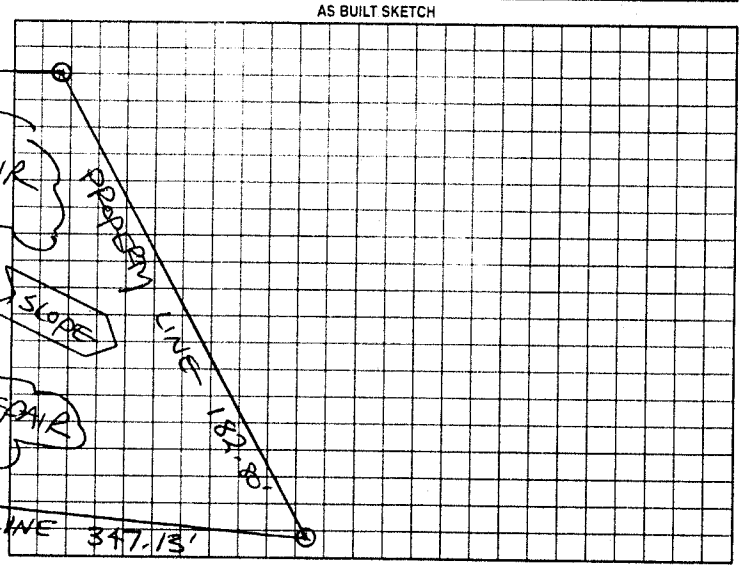

Permit can be suspended or revoked if any false information is supplied toward securing the permit/any unauthorized changes are made to the site/any unauthorized changes are made in the installation of the system. Improvement Permit with plat valid without expiration. Improvement Permit with site plan valid for sixty months. Authorization to Construct is valid for a period equal to that of Improvement Permit – not to exceed sixty months.

Signed: Brent Murdock date 6/8/99 Installed by: CRAIG THOMPSON

Improvement Permit by: STEVE HENDRICK date 2-5-99 Operation Permit by: C Fisher date May 31 2000

Authorization to Construct by: STEVE HENDRICK date 2-5-99 Existing System Inspection by: date

HEALTH DEPT COPY: WHITE OWNER COPY (FINAL) YELLOW OWNER COPY (INITIAL) PINK