IREDELL COUNTY HEALTH DEPARTMENT

STATESVILLE 704-878-5305 MOORESVILLE 704-664-5281

IMPROVEMENT PERMIT / AUTHORIZATION TO CONSTRUCT / OPERATION PERMIT / EXISTING SYSTEM INSPECTION

PERMIT# 079683 PIN# 4789 12 0890 DATE 3-16-99

OWNER OR CONTRACTOR ROGER TEMPLETON PHONE: Business 873-1014 Home

ADDRESS 590 MOCKSVILLE HIGHWAY, STATESVILLE, NC 28625

LOCATION US 21 N, TR MT. BETHEL, TL SHAW, TR STAGECREST, 2ND LOT ON RIGHT

SUBDIVISION RIMROCK EST BLOCK / SECTION LOT 11 LOT AREA 0.646 ACRE SITE CLASS PS DESIGN FLOW 360 L.T.A.R. 0.30 GPD/FT²

Septic Tank: 1000 Gallons; STB Date 6-11-99
Pump Tank: Gallons; PT Date
Pump Make: Model Serial No.
Nitrification Field: No Fields 1 Square Feet 1200 Linear Feet 400
No Lines FOUR Trench Width 36" Max Trench Bottom Depth 30" Gravel Depth 12"

☑ New System ☐ Repair System Type: ☐ II ☐ III ☐ IV ☐ V ☐ VI
System Description: CONVENTIONAL GRAVITY
Repair System Description: CONV. GRAVITY/PUMP
Maintenance Agreement Required: ☐ Yes ☑ No

☐ House/Mod. Home ☑ Mobile Home ☐ Business ☐ Other
No. Bedrooms 3 No. Bathrooms 2 No. Employees


☐ Slab ☐ Crawl Space ☐ Basement w/plumbing ☐ Basement wo/plumbing

Water Supply: ☐ Individual ☑ Public ☐ Community


Comments/Conditions: DROP BOXES (3)

Comments/Conditions

INITIAL SITE SKETCH

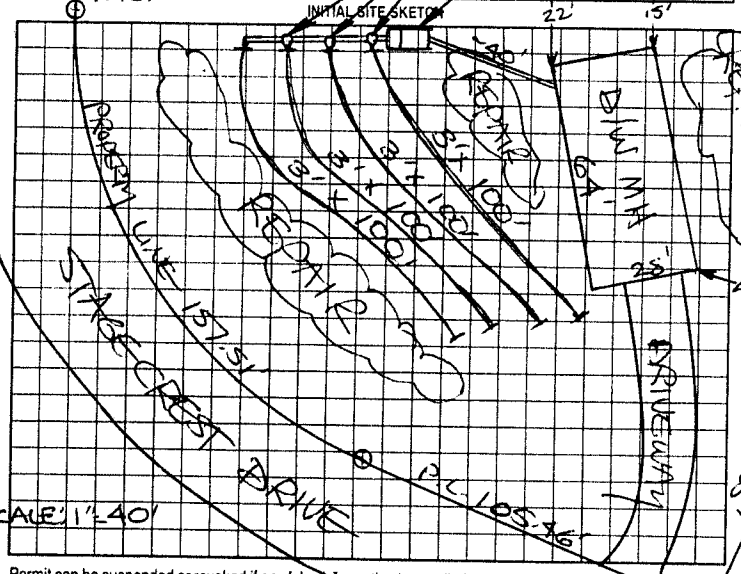

AS BUILT SKETCH

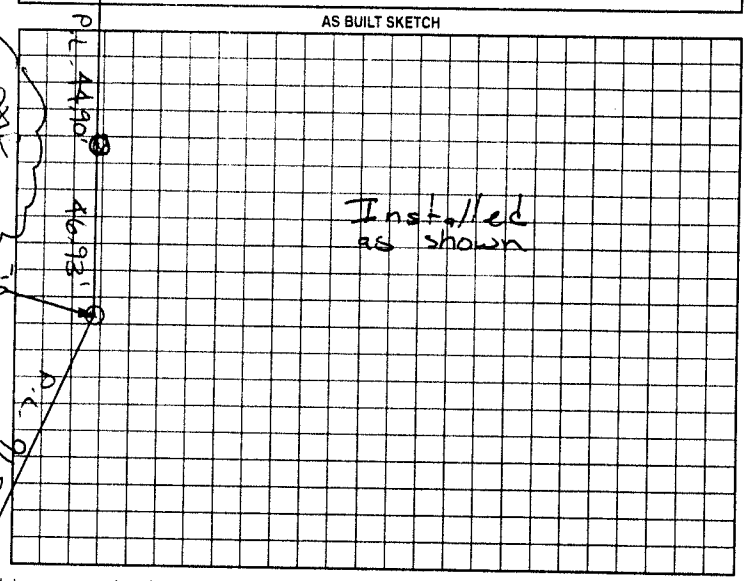

Permit can be suspended or revoked if any false information is supplied toward securing the permit/any unauthorized changes are made to the site/any unauthorized changes are made in the installation of the system. Improvement Permit with plat valid without expiration. Improvement Permit with site plan valid for sixty months. Authorization to Construct is valid for a period equal to that of Improvement Permit – not to exceed sixty months.

Signed: Ben Anders date 3-17-99 Installed by: Sammy Beals

Improvement Permit by: STEVE HEDRICK date 3-16-99 Operation Permit by: [illegible] RS date 7-29-99

Authorization to Construct by: STEVE HEDRICK date 3-16-99 Existing System Inspection by: date

HEALTH DEPT COPY WHITE OWNER COPY (FINAL) YELLOW OWNER COPY (INITIAL) PINK