IREDELL COUNTY HEALTH DEPARTMENT

STATESVILLE 704-878-5305 NOT FOUND MOORESVILLE 704-664-5281

IMPROVEMENT PERMIT / AUTHORIZATION TO CONSTRUCT / OPERATION PERMIT / EXISTING SYSTEM INSPECTION

PERMIT# 09165 PIN# 4789.12.0903 DATE 10-6-00

OWNER OR CONTRACTOR RICHARD SUTHERLAND PHONE: Business Home (540) 859-9491

ADDRESS HC 4 BOX 28 D, BEE VA, 24217

LOCATION US 21 N, TR BETHEL RD, TL SHAW RD, TR STAGECREST DR, 3RD LOT ON RIGHT

SUBDIVISION RIMROCK EST BLOCK / SECTION LOT 12 LOT AREA 0.666 ACRE SITE CLASS PS DESIGN FLOW 360 L.T.A.R. 0.30 GPD/FT²

Septic Tank: 1000 Gallons; STB 1017 Date 4-16-03

Pump Tank: 1000 Gallons; PT 17 Date 8-16-03

Pump Make: MYERS Model MWSD-IIP Serial No. 26038D901

Nitrification Field: No Fields 1 Square Feet 1200 Linear Feet 400

No Lines FOUR Trench Width 36" Max Trench Bottom Depth 36" Gravel Depth 12"

☑ New System ☐ Repair System Type: I, II, III, IV, V, VI

System Description: CONVENTIONAL, PUMP

Repair System Description: 50% REDUCTION, PUMP

Maintenance Agreement Required: ☐ Yes ☑ No

☐ House/Mod. Home ☑ Mobile Home ☐ Business ☐ Other

No. Bedrooms 3 No. Bathrooms 2 No. Employees


☐ Slab ☑ Crawl Space ☐ Basement w/plumbing ☐ Basement wo/plumbing

Water Supply: ☐ Individual ☒ Public ☐ Community


Comments:/Conditions: SEE ATTACHED SHEETS FOR PUMP AND PRESSURE MANIFOLD REQUIREMENTS

Comments:/Conditions: TUFF TITE FILTER & MARKER INSTALLED AS DRAWN
NEEDS PRESSURE, ELECTRICAL, & BEGINNING OF DITCHES NEEDS FALL & XTRA GRAVEL

INITIAL SITE SKETCH

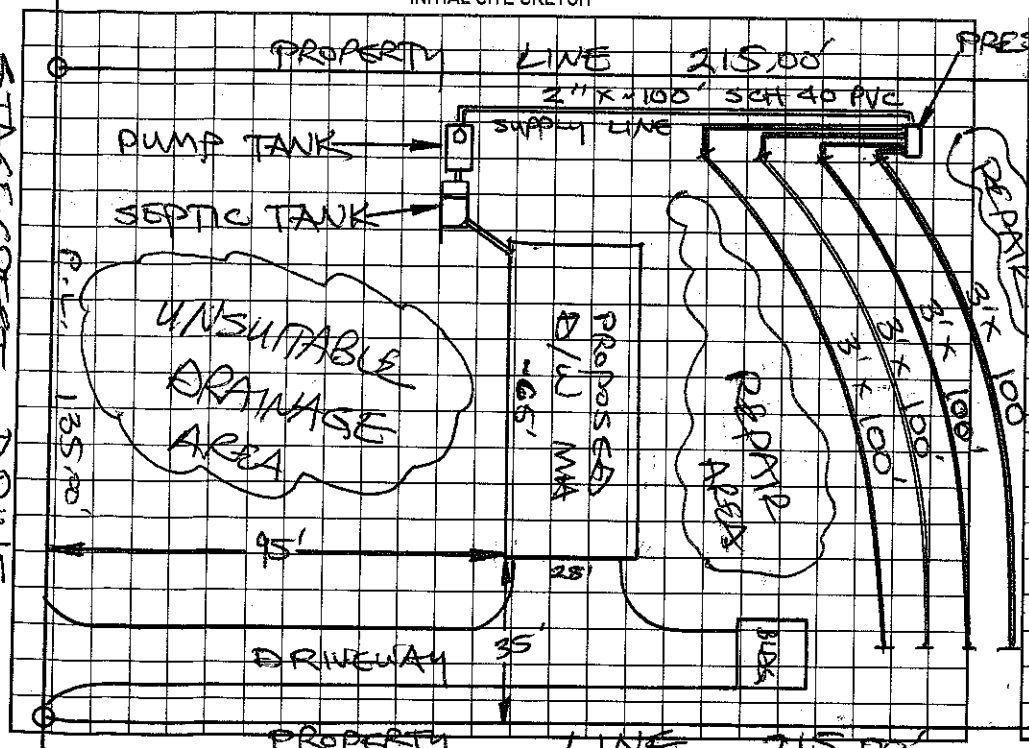

AS BUILT SKETCH

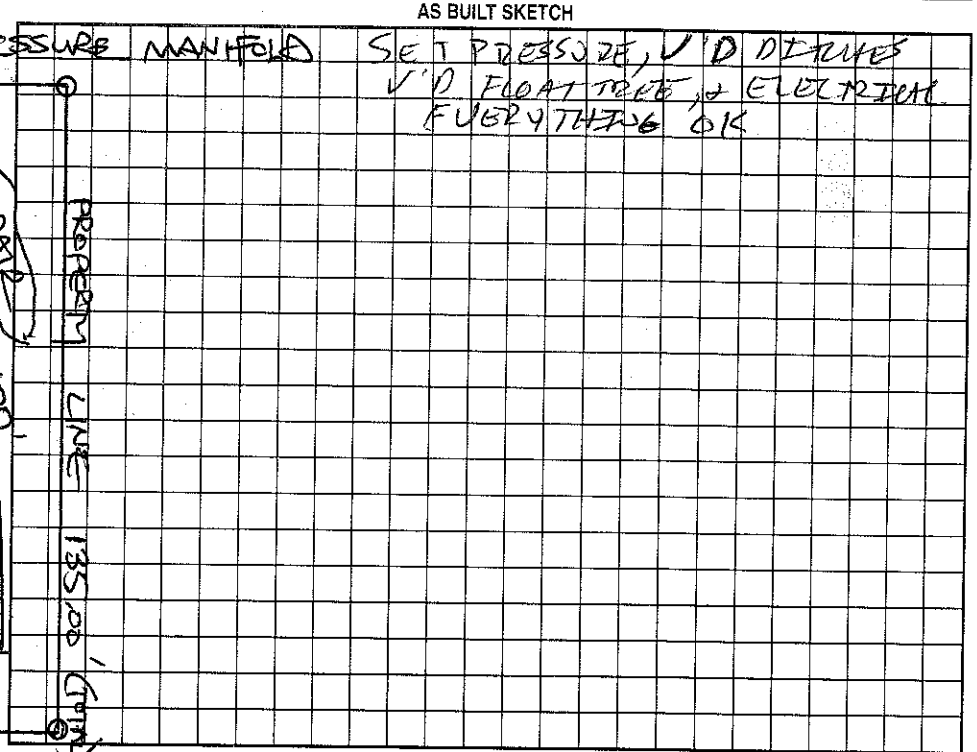

Permit can be suspended or revoked if any false information is supplied toward securing the permit/any unauthorized changes are made to the site/any unauthorized changes are made in the installation of the system. Improvement Permit with plat valid without expiration. Improvement Permit with site plan valid for sixty months. Authorization to Construct is valid for a period equal to that of Improvement Permit – not to exceed sixty months.

Signed: + Richard P. Sutherland date 10-6-00

Improvement Permit by: STEVE HEDRICK date 10-6-00

Authorization to Construct by: STEVE HEDRICK date 10-6-00

Installed by: CRAIG THOMPSON

Operation Permit by: date 11-4-03

Existing System Inspection by: date

HEALTH DEPT. COPY: WHITE OWNER COPY (FINAL): YELLOW OWNER COPY (INITIAL): PINK