IREDELL COUNTY HEALTH DEPARTMENT

Statesville Office (704) 878-5305 Mooresville Office (704) 660-3625 PERMIT # 218915

IMPROVEMENT PERMIT / AUTHORIZATION TO CONSTRUCT / OPERATION PERMIT / EXISTING SYSTEM

PIN # 4789120903

APPLICANT: LARRY PITMAN APPLICANT ADDRESS: 111 EAGLEWOOD DR.

SITE ADDRESS: 132 STAGECREST DR. HARMONY PHONE: ALT. PHONE: 704 380 2811

SITE DIRECTIONS: 21 N - TR MT BETHANY - TL SHAW - TR STAGECREST ON RT

SUBDIVISION: RIM ROCK ESTATES SECTION: LOT # 12 LOT AREA: .67 AC DESIGN FLOW: 360 L.T.A.R.: EASEMENT

Septic Tank ____ (gal) STB ____ Date ____

Pump Tank ____ (gal) PT ____ Date ____

Pump Make ____ Model ES 1PNE Serial # ____

Nitrification Fields ____ # Lines ____ Linear Ft: ____

Trench Width ____ Max. Trench Bottom Depth ____ Gravel Depth ____

☑ New System ☐ Repair ☐ Expansion System Type: I II (III) IV V VI

System Description: PUMP CONVENTIONAL

Repair System Description: LP PPBPS

Maintenance Agreement Required: ☐ YES ☑ NO ☐ GRAVITY ☑ PRESSURE

☑ Residence ☐ Business ☐ Other ☐ Slab ☐ Basement w/plumbing


No. Bedrooms 3 No. Persons 2 No. Employees ____ ☑ Crawl Space ☐ Basement w/o plumbing

Water Supply: ☐ Private ☑ Public ☐ Community

Comments / Conditions:

INITIAL SITE SKETCH

AS BUILT SKETCH

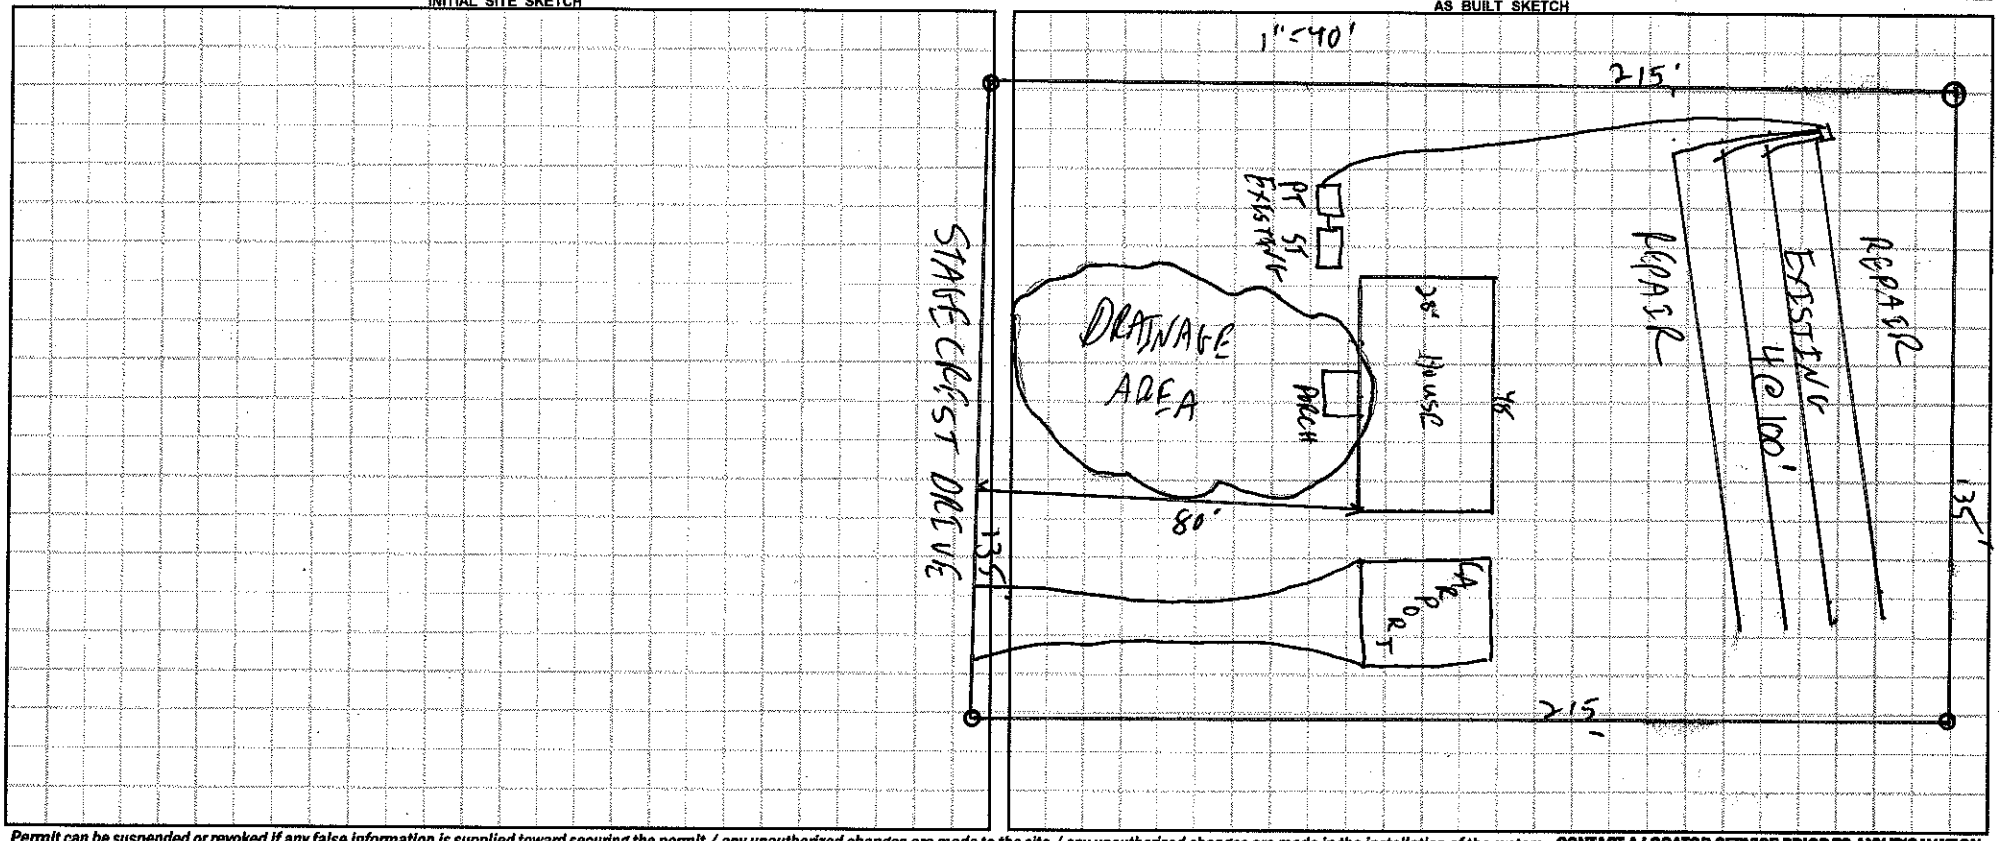

Permit can be suspended or revoked if any false information is supplied toward securing the permit / any unauthorized changes are made to the site / any unauthorized changes are made in the installation of the system. **CONTACT A LOCATOR SERVICE PRIOR TO ANY EXCAVATION**

☐ **IMPROVEMENT PERMIT** *with plat valid without expiration.* ☐ **IMPROVEMENT PERMIT** *with site plan valid for 60 mos.* ☐ **AUTHORIZATION TO CONSTRUCT** *valid for period equal to IMPROVEMENT PERMIT--not to exceed 60 mo.*

Owner / Applicant Signature: Picked up w/o signature Date: 7/5/16 Installed by: ____

IMPROVEMENT PERMIT by: ____ Date: ____ OPERATION PERMIT by: ____ Date: ____

AUTHORIZATION TO CONSTRUCT by: ____ Date: ____ Existing System Inspected by: [signature] Date: 6/29/16

Health Dept. Copy - WHITE Applicant (Final Approval) - YELLOW Applicant (Conditional Approval) - PINK