IREDELL COUNTY HEALTH DEPARTMENT

STATESVILLE 704-878-5305 MOORESVILLE 704-664-5281

IMPROVEMENT PERMIT / AUTHORIZATION TO CONSTRUCT / OPERATION PERMIT / EXISTING SYSTEM INSPECTION

PERMIT# 079834 PIN# 4789 12 2547 DATE 3-24-99

OWNER OR CONTRACTOR LARRY PALMER PHONE: Business Home (336) 993-5207

ADDRESS 9260 SAHABI ROAD, KERNERSVILLE, NC 27284

LOCATION US 21 NORTH, TR BETHEL RD, TR SHAW ROAD TR, STAGECREST DRIVE, 2ND LOT ON LEFT

SUBDIVISION RIMROCK EST BLOCK / SECTION LOT 4 LOT AREA 1.017 ACRES SITE CLASS PS DESIGN FLOW 600 L.T.A.R. 0.35 GPD/FT²

Septic Tank: 1500 Gallons; STB 964 Date 2-10-99

Pump Tank: Gallons; PT Date

Pump Make: Model Serial No.

Nitrification Field: No Fields 1 Square Feet 1710 Linear Feet 570

No Lines FOUR Trench Width 36" Max Trench Bottom Depth 36" Gravel Depth 12"

☐ New System ☐ Repair System Type: I ☒ II III IV V VI

System Description: CONVENTIONAL GRAVITY

Repair System Description: 25% REDUCTION GRAVITY

Maintenance Agreement Required: ☐ Yes ☒ No

☐ House/Mod. Home ☑ Mobile Home ☐ Business ☐ Other

No. Bedrooms 5 No. Bathrooms 3 No. Employees


☐ Slab ☒ Crawl Space ☐ Basement w/plumbing ☐ Basement wo/plumbing

Water Supply: ☐ Individual ☒ Public ☐ Community


Comments/Conditions:

Comments/Conditions: SEPTIC TANK WITH RISERS INSTALLED USING "ZABEL" FILTER

INITIAL SITE SKETCH

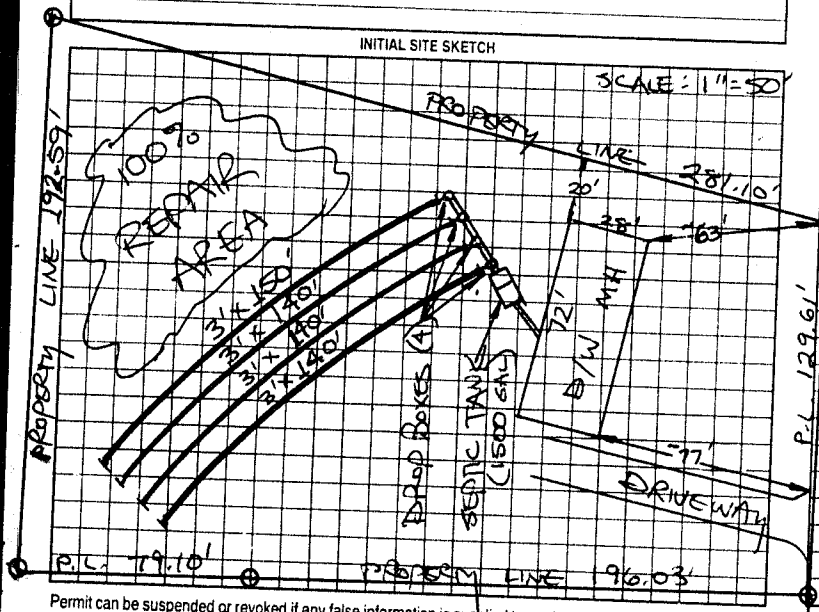

AS BUILT SKETCH

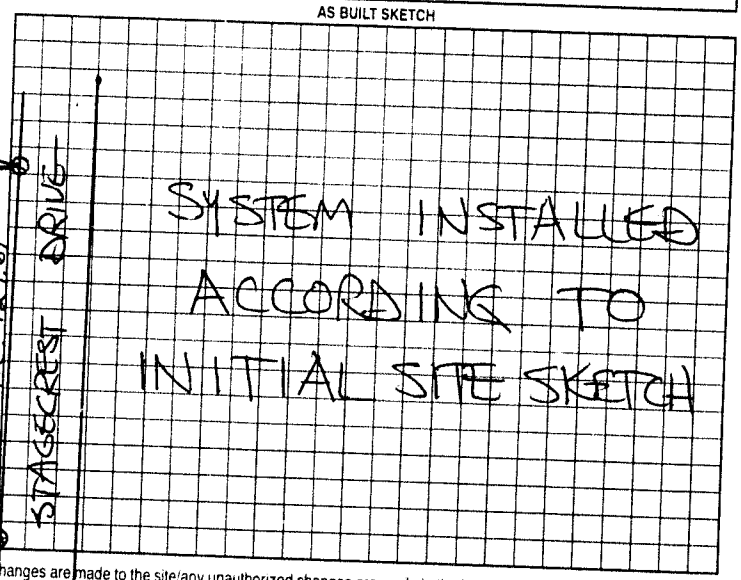

Permit can be suspended or revoked if any false information is supplied toward securing the permit/any unauthorized changes are made to the site/any unauthorized changes are made in the installation of the system. Improvement Permit with plat valid without expiration. Improvement Permit with site plan valid for sixty months. Authorization to Construct is valid for a period equal to that of Improvement Permit – not to exceed sixty months.

Signed: Larry C. Palmer date 3-24-99

Improvement Permit by: STEVE HEDRICK date 3-24-99

Authorization to Construct by: STEVE HEDRICK date 3-24-99

Installed by: SHERMAN DUNN

Operation Permit by: STEVE HEDRICK date 5-4-99

Existing System Inspection by: date

HEALTH DEPT COPY WHITE OWNER COPY (FINAL) YELLOW OWNER COPY (INITIAL) PINK