IREDELL COUNTY HEALTH DEPARTMENT

STATESVILLE 704-878-5305 MOORESVILLE 704-664-5281

IMPROVEMENT PERMIT / AUTHORIZATION TO CONSTRUCT / OPERATION PERMIT / EXISTING SYSTEM INSPECTION

PERMIT # 56884 PIN # 4789 123843 34 DATE 16 June 09

OWNER or APPLICANT Carl & Marina Blattner PHONE: Business Home:

OWNER or APPLICANT ADDRESS 131 Shaw RD Harmony NC 28634

LOCATION / DIRECTIONS 21N (TR) Mt Bethel (TL) Shaw 131 Shaw RD

SUBDIVISION Runrock Estates BLOCK / SECTION LOT # 5 LOT AREA .79 DESIGN FLOW 360 L.T.A.R. .3

Septic Tank 1000 Gallons: STB 928 Date 6-26-98

Pump Tank Gallons: P T Date

Pump Make Model Serial #

Nitrification Field No Fields 1 No Lines 4 Linear Feet 400

Trench Width 36" Max. Trench Bottom Depth 36" Gravel Depth 12"

☐ ~~New System~~ Exst ☐ Repair ☐ Expansion System Type I II III IV V VI

System Description: Gravel Conventional

Repair System Description: 50% LPP

Maintenance Agreement Required ☐ YES ☐ NO

☑ GRAVITY ☐ PRESSURE

☑ Residence No. Bedrooms 3

☐ Business No. Persons

☐ Other No. Employees

☐ Slab ☑ Crawl Space


☐ Basement w/plumbing ☐ Basement w/o plumbing

Water Supply ☐ Private ☑ Public ☐ Community

Comments / Conditions

Comments / Conditions
Maintain setback from septic lines

INITIAL SITE SKETCH

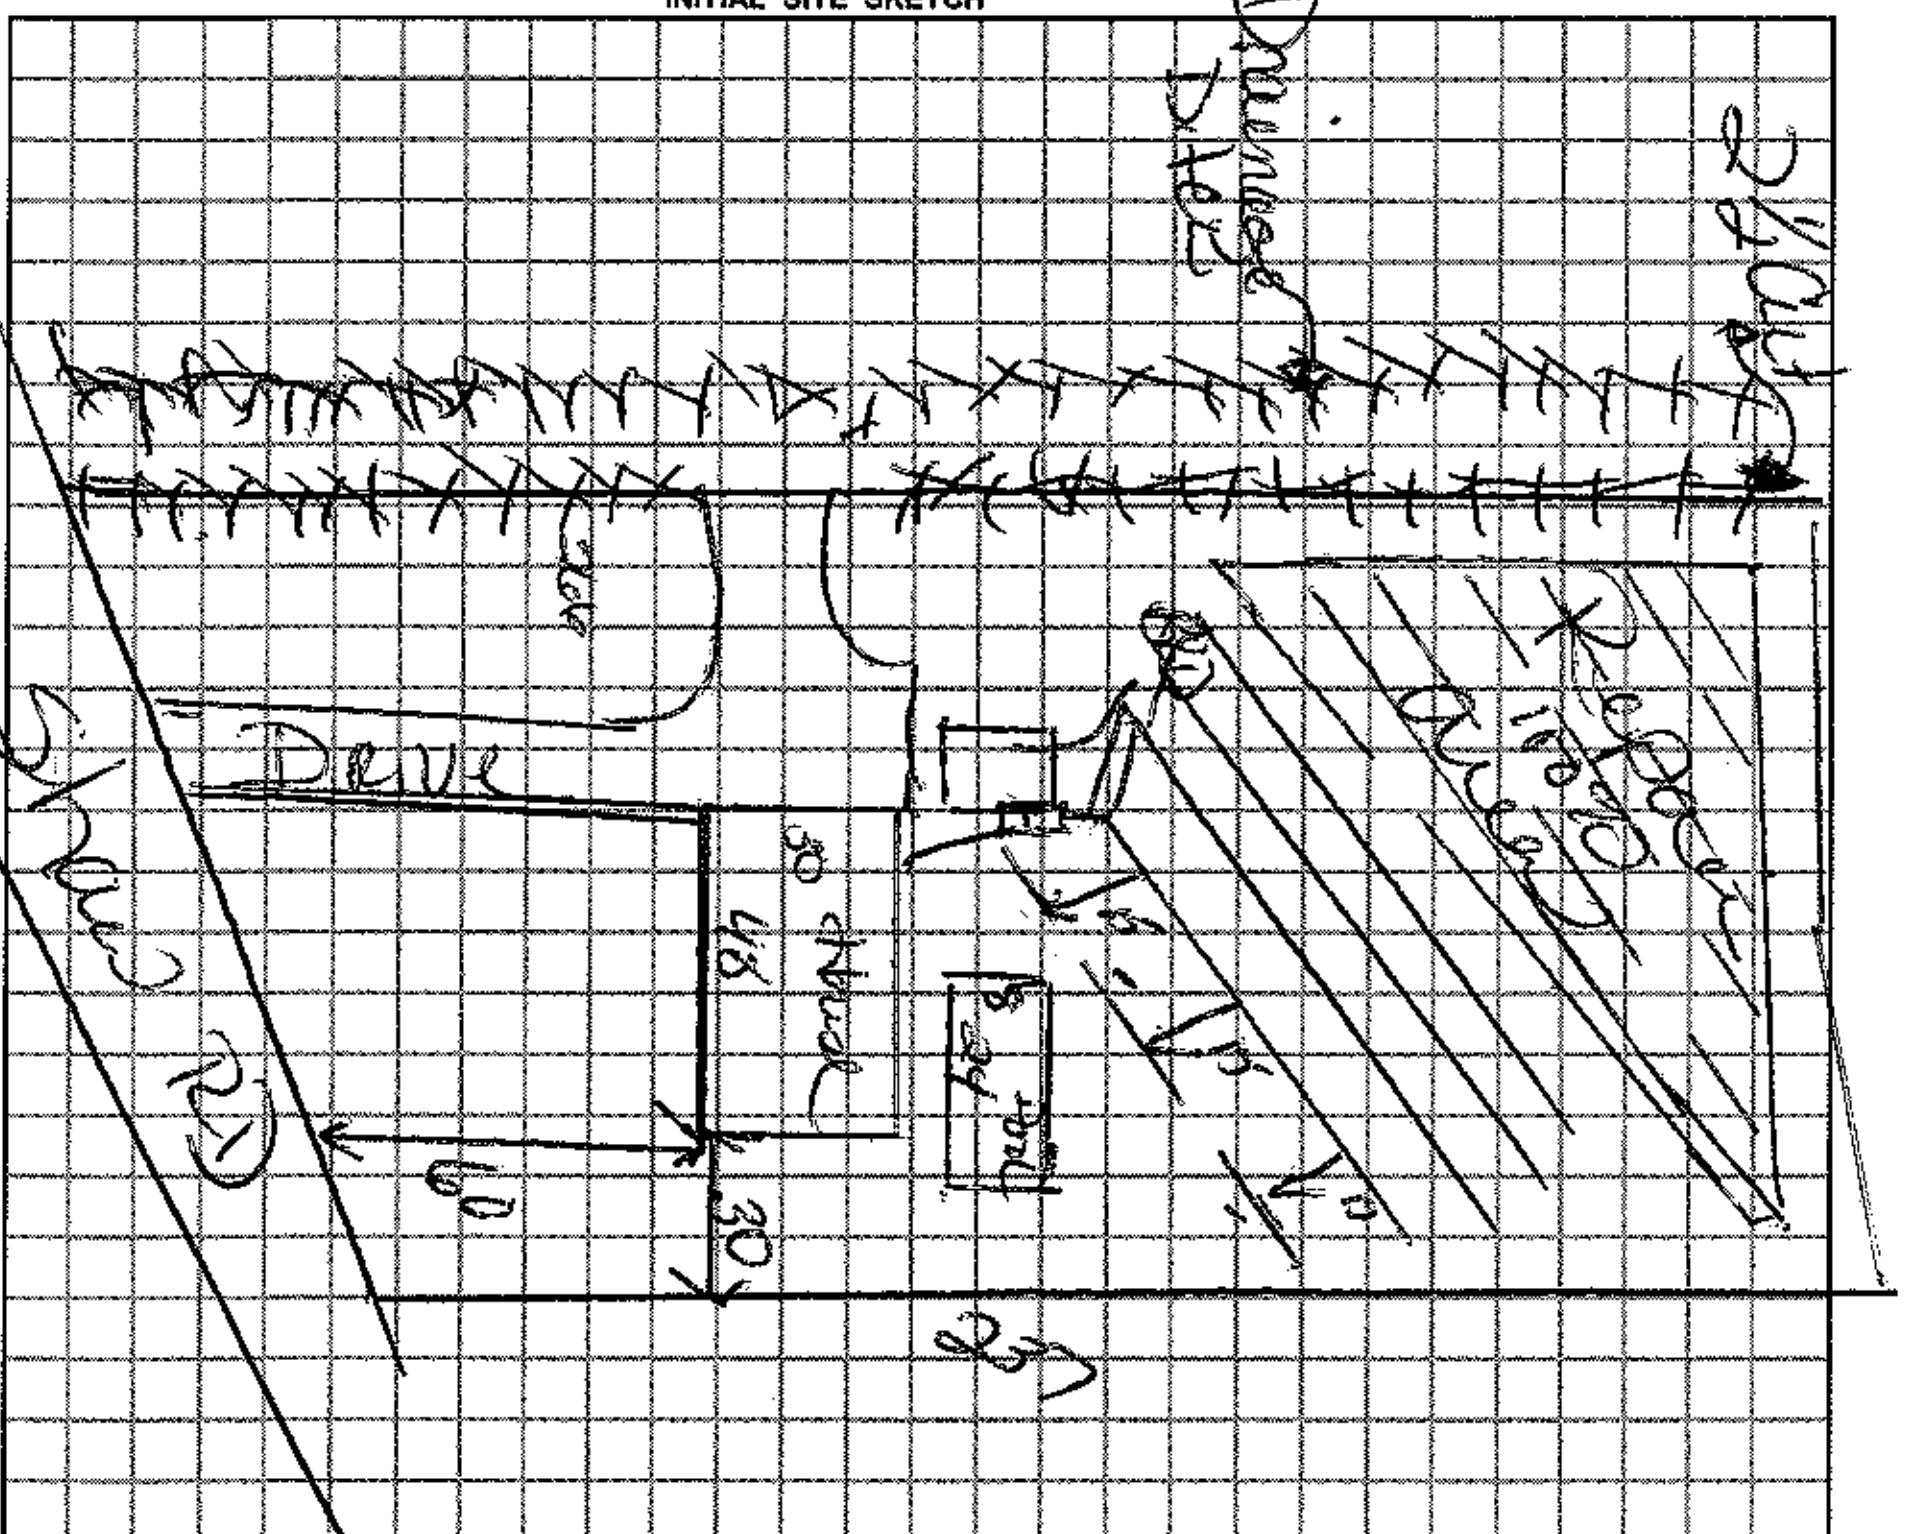

AS BUILT SKETCH

Blue/White flags 15' off Septic line
White/white flags pool area
Maintain 15' off septic lines with cut for pool

Permit can be suspended or revoked if any false information is supplied toward securing the permit / any unauthorized changes are made to the site / any unauthorized changes are made in the installation of the system.

☐ *IMPROVEMENT PERMIT w / plat valid without expiration.* ☐ *IMPROVEMENT PERMIT w / site plan valid for 60 mos.* ☐ *AUTHORIZATION TO CONSTRUCT valid for period equal to IMPROVEMENT PERMIT-not to exceed 60 mo.*

Owner / Applicant Signature: Marina Blattner Date 6-16-09 Installed by:

Improvement Permit by: Kent Cox Date 16 June 09 ~~Operation Permit~~ by: Kent Cox Date: 16 June 09

Authorzation to Construct by: Kent Cox Date 16 June 09 Existing System Inspected by: Date:

YOU SHOULD CONTACT A LOCATOR SERVICE PRIOR TO ANY EXCAVATION.

WHITE COPY Environmental Health YELLOW COPY (Final) Owner / Applicant PINK COPY (Initial) Owner / Applicant