IREDELL COUNTY HEALTH DEPARTMENT

STATESVILLE 704-878-5305 MOORESVILLE 704-664-5281

IMPROVEMENT PERMIT / AUTHORIZATION TO CONSTRUCT / OPERATION PERMIT / EXISTING SYSTEM INSPECTION

PERMIT# 082610 PIN# 4789 21 4595 DATE 7-29-99

OWNER OR CONTRACTOR KIMBRA SUTHERLAND PHONE: Business Home 876-6391

ADDRESS 369 JENNINGS ROAD STATESVILLE, NC 28625

LOCATION US 21 N, TR MT. BETHEL, TL SHAW, LOTS AT END ON RIGHT

SUBDIVISION RIMROCK EST. BLOCK / SECTION LOT 1 & 2 LOT AREA 1.696 ACRES SITE CLASS PS DESIGN FLOW 360 L.T.A.R. 0.30 GPD/FT2

Septic Tank: 1000 Gallons; STB 794 Date 9-13-99

Pump Tank: Gallons; PT Date

Pump Make: Model Serial No.

Nitrification Field: No Fields 1 Square Feet 1200 Linear Feet 400

No Lines SIX Trench Width 36" Max Trench Bottom Depth 36" Gravel Depth 12"

☑ New System ☐ Repair System Type: I II III IV V VI

System Description: CONVENTIONAL GRAVITY

Repair System Description: CONVENTIONAL PUMP

Maintenance Agreement Required: Yes No

☐ House/Mod. Home No. Bedrooms 3

☐ Mobile Home No. Bathrooms 2½

☐ Business No. Employees

☐ Other


☐ Slab ☑ Crawl Space ☐ Basement w/plumbing ☐ Basement wo/plumbing

Water Supply: ~~Municipal~~ ☑ Public ☐ Community


Comments/Conditions: PROPOSED LINE 18L23R

Comments/Conditions: SEPTIC TANK WITH MARKER INSTALLED USING "POLYLOK" FILTER

INITIAL SITE SKETCH

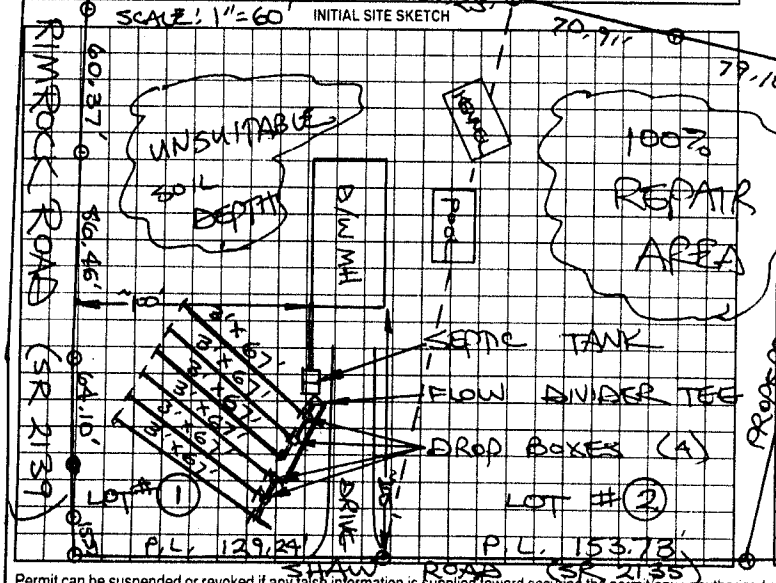

AS BUILT SKETCH

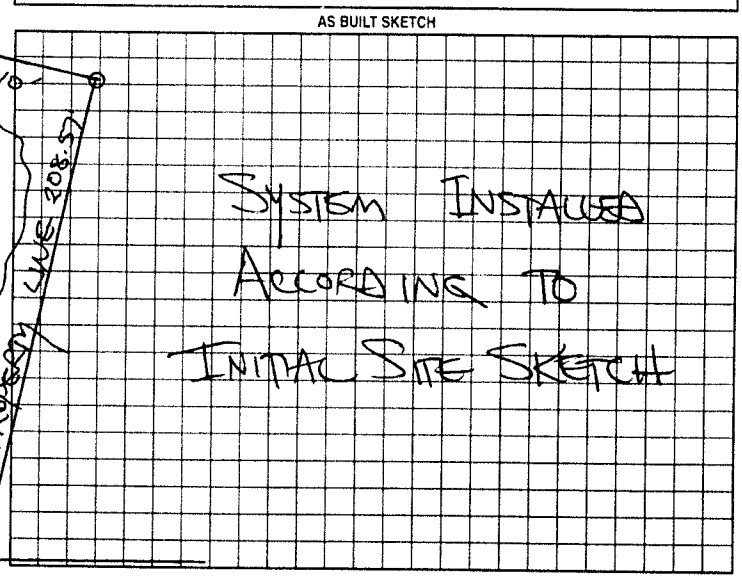

Permit can be suspended or revoked if any false information is supplied toward securing the permit, any unauthorized changes are made to the site, any unauthorized changes are made in the installation of the system. Improvement Permit with plat valid without expiration. Improvement Permit with site plan valid for sixty months. Authorization to Construct is valid for a period equal to that of Improvement Permit -- not to exceed sixty months.

Signed: Kimbra Sutherland date 7-29-99 Installed by: COMMERCIAL SERVICES (JERRY WEITER)

Improvement Permit by: STEVE HEDRICK date 7-29-99 Operation Permit by: STEVE HEDRICK date 10-21-99

Authorization to Construct by: STEVE HEDRICK date 7-29-99 Existing System Inspection by: date

HEALTH DEPT COPY WHITE OWNER COPY (FINAL) YELLOW OWNER COPY (INITIAL) PINK