# IREDELL COUNTY HEALTH DEPARTMENT

STATESVILLE 704-878-5305 MOORESVILLE 704-664-5281

(c1)

## IMPROVEMENT PERMIT / AUTHORIZATION TO CONSTRUCT / OPERATION PERMIT / EXISTING SYSTEM INSPECTION

PERMIT # 160720 PIN # 4789-12-4633 DATE APRIL 15, 2010

OWNER or APPLICANT CHRISTINA & COREY SARCONA PHONE: Business 704-883-6675 Home: 704-883-6676

OWNER or APPLICANT ADDRESS 105 STAGECREST LANE HARMONY NC 28634

LOCATION / DIRECTIONS US 21 N, TR BETHEL RD, TL SHAW ROAD, R RIGHT AT STAGECREST LANE

SUBDIVISION RIMROCK ESTATES BLOCK / SECTION LOT # 3 LOT AREA 0.85 AC DESIGN FLOW 480 L.T.A.R. 0.30 GPD/FT²

Septic Tank 1000 Gallons: STB 1012 Date 5/23/98

Pump Tank Gallons: P T Date

Pump Make Model Serial #

Nitrification Field No Fields 1 No Lines 4 Linear Feet 400

Trench Width 36" Max. Trench Bottom Depth 36" Gravel Depth N/A

☐ New System ☐ Repair ☐ Expansion System Type I II III IV V VI

System Description: 25% REDUCTION, GRAVITY

Repair System Description: 25% REDUCTION, GRAVITY

Maintenance Agreement Required ☐ YES ☒ NO

☐ GRAVITY ☐ PRESSURE

☑ Residence No. Bedrooms 4

☐ Business No. Persons

☐ Other No. Employees

☐ Slab ☑ Crawl Space

☐ Basement w/plumbing ☐ Basement w/o plumbing


Water Supply: ☐ Private ☑ Public ☐ Community

Comments / Conditions

Comments / Conditions

P.L. - 209'

INITIAL SITE SKETCH

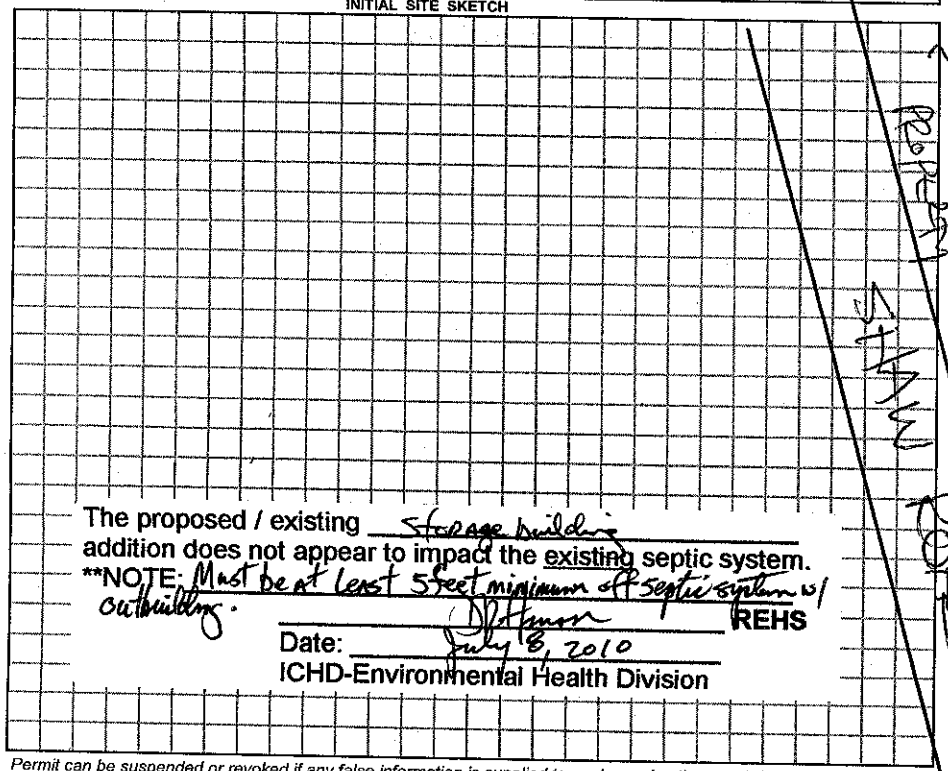


The proposed / existing storage building addition does not appear to impact the existing septic system.


**NOTE: Must be at least 5 feet minimum off septic system w/ outbuilding.

REHS

Date: July 8, 2010

ICHD-Environmental Health Division

AS BUILT SKETCH

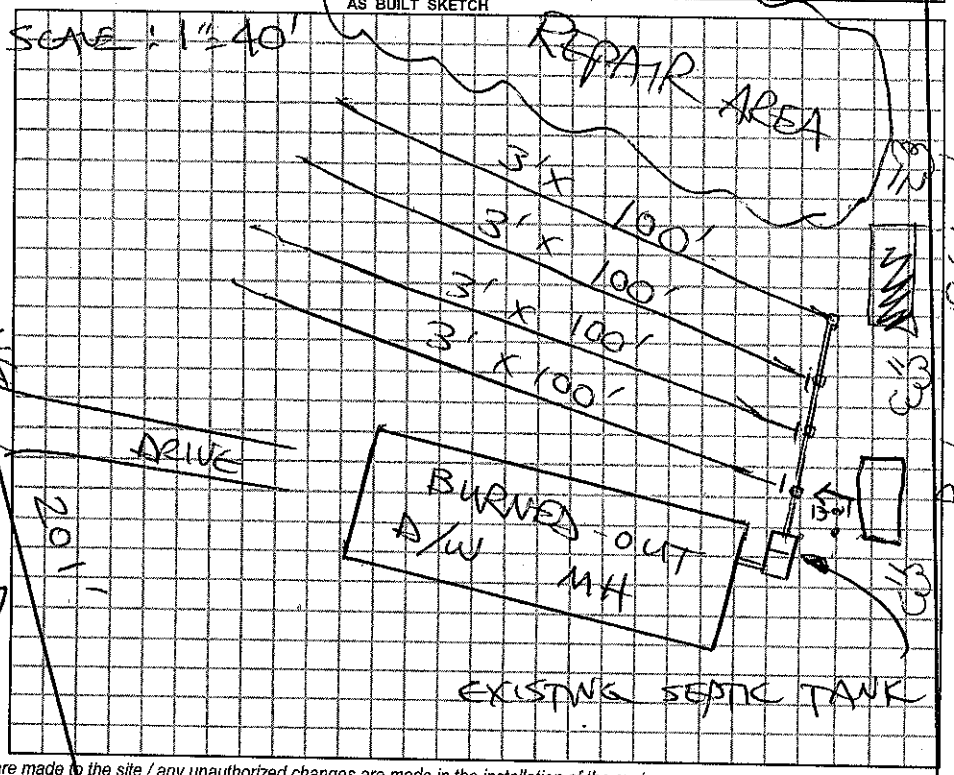


*Permit can be suspended or revoked if any false information is supplied toward securing the permit / any unauthorized changes are made to the site / any unauthorized changes are made in the installation of the system.*

☐ IMPROVEMENT PERMIT w / plat valid without expiration. ☐ IMPROVEMENT PERMIT w / site plan valid for 60 mos. ☐ AUTHORIZATION TO CONSTRUCT valid for period equal to IMPROVEMENT PERMIT-not to exceed 60 mo.

Owner / Applicant Signature: Date

Improvement Permit by: Date

Authorzation to Construct by: Date

***YOU SHOULD CONTACT A LOCATOR SERVICE PRIOR TO ANY EXCAVATION.***

Installed by:

Operation Permit by: Date:

Existing System Inspected by: STEVE HENDRICK Date: 4/15/2010

WHITE COPY Environmental Health YELLOW COPY (Final) Owner / Applicant PINK COPY (Initial) Owner / Applicant