4789 12 4633

IREDELL COUNTY HEALTH DEPARTMENT

STATESVILLE 704-878-5305 MOORESVILLE 704-664-5281

IMPROVEMENT PERMIT / AUTHORIZATION TO CONSTRUCT / OPERATION PERMIT / EXISTING SYSTEM INSPECTION

PERMIT# 075067 PIN# 4789 21 5589 (PART) DATE 7-13-98

OWNER OR CONTRACTOR CHRISTINA SARCONA PHONE: Business Home 546-5041

ADDRESS 219 JEFFERSON ST STATEN ISLAND NY 08520

LOCATION US 21 N, TR MT. BETHEL ROAD, TL SHAW ROAD, LOT ON RIGHT AT STAGECREST DRIVE

SUBDIVISION BIRMROCK EST. BLOCK / SECTION LOT 3 LOT AREA 0.84 ACRE SITE CLASS PS DESIGN FLOW 480 L.T.A.R. 0.30 gpd/ft²

Septic Tank: 1000 Gallons; STB 1012 Date 5-23-98
Pump Tank: Gallons; PT Date
Pump Make: Model Serial No.
Nitrification Field: No Fields 1 Square Feet 60 to 1200 Linear Feet 300+
No Lines FOUR Trench Width 36" Max Trench Bottom Depth 36" Sand Depth 6"

☒ New System ☐ Repair System Type: I, II, (III) IV, V, VI
System Description: 25% REDUCTION-GRAVITY
Repair System Description: 25% REDUCTION-Pump/gravity
Maintenance Agreement Required: ☐ Yes ☒ No

☐ House/Mod. Home ☒ Mobile Home ☐ Business ☐ Other
No. Bedrooms 4 No. Bathrooms 2 No. Employees


☐ Slab ☒ Crawl Space ☐ Basement w/plumbing ☐ Basement wo/plumbing

Water Supply: ☐ Individual ☒ Public ☐ Community

Comments:/Conditions: INSTALL 25% REDUCTION SYSTEM AS FLAGGED ON CONTOUR (50 CHAMBERS OR 30 HDS LENGTHS)

Comments:/Conditions:

INITIAL SITE SKETCH

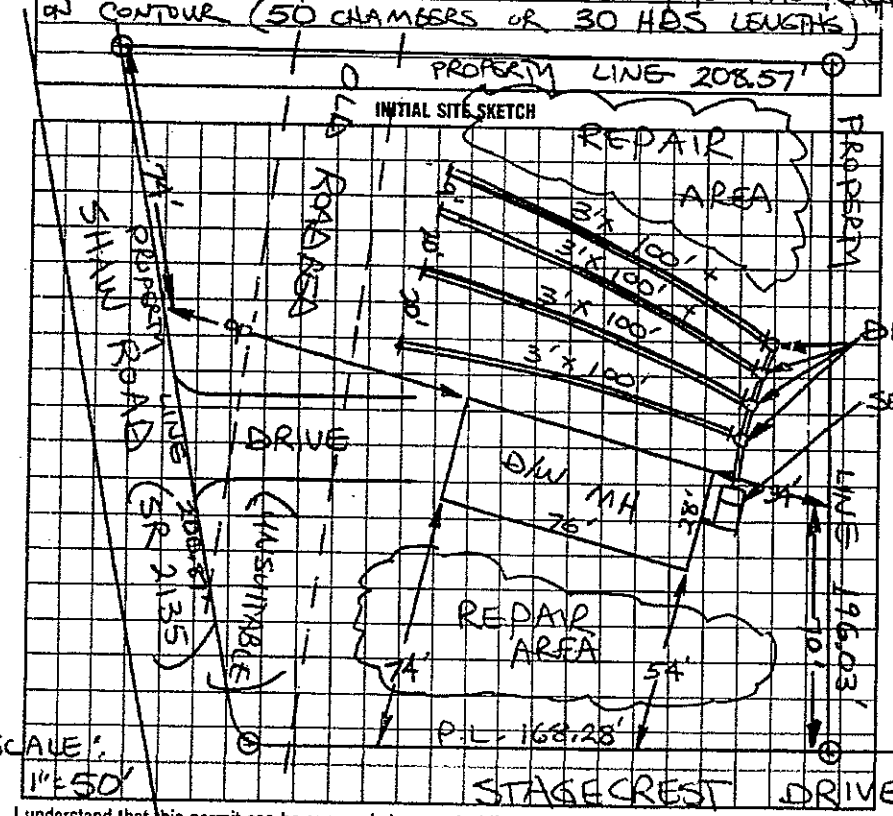

AS BUILT SKETCH

Installed as shown

Location of the proposed Above ground pool addition does not appear to impact the existing on-site septic system.**NOTE: Must be 15' from septic system with pool.

REHS

Date: July 23, 2013

ICHD-Environmental Health Division

I understand that this permit can be suspended or revoked if any false information is supplied toward securing the permit/any unauthorized changes are made to the site/any unauthorized changes are made in the installation of the system. Improvement Permit with plat valid without expiration. Improvement Permit with site plan valid for sixty months. Authorization to Construct is valid for a period equal to that of Improvement Permit – not to exceed sixty months.

Signed: Jonny Miller Integrity Homes date 7-14-98

Improvement Permit by: STEVE HENDRICK date 7-13-98

Authorization to Construct by: STEVE HENDRICK date 7-13-98

Installed by: A-1 Backhoe

Operation Permit by: Mary Conforto date 7-21-98

Existing System Inspection by: date

HEALTH DEPT. COPY: WHITE INSPECTION COPY (FINAL): GREEN OWNER COPY (FINAL): YELLOW INSPECTION COPY (INITIAL): PINK OWNER COPY (INITIAL): GOLD