IREDELL COUNTY HEALTH DEPARTMENT

STATESVILLE 704-878-5305 (C) MOORESVILLE 704-664-5281

IMPROVEMENT PERMIT / AUTHORIZATION TO CONSTRUCT / OPERATION PERMIT / EXISTING SYSTEM INSPECTION

PERMIT# 105600 PIN# 4789-21-3702 DATE 4-12-02

OWNER OR CONTRACTOR JOHNNY ABEE PHONE Business Home 704-546-2582

ADDRESS 132 THOMAS ROCK DRIVE, HARMONY NC 28634

LOCATION US 21 NORTH, TR BETHEL ROAD, TL SHAW RD, TL RIMROCK ROAD, 1ST DRIVE ON LEFT

SUBDIVISION BLOCK / SECTION LOT LOT AREA FIVE ACRES SITE CLASS PS DESIGN FLOW 360' L.T.A.R. 0.50 GPD/FT²

Septic Tank: 1000 Gallons. STB 620 Date 6-12-02
Pump Tank: Gallons. PT Date
Pump Make: Model Serial No
Nitrification Field: No Fields 1 Square Feet 720 Linear Feet 240
No Lines FOUR Trench Width 36" Max Trench Bottom Depth 36" Gravel Depth 12"

✓ New System Repair System Type I II III IV V
System Description CONVENTIONAL GRAVITY
Repair System Description CONVENTIONAL GRAVITY
Maintenance Agreement Required Yes ✓ No
Slab Crawl Space Basement w/plumbing ✓ Basement wo/plumbing


✓ House/Mod Home No Bedrooms 3
Mobile Home No Bathrooms 2
Business No Employees
Other

Water Supply:
☐ Individual
✓ Public
☐ Community


Comments/Conditions: KEEP SYSTEM MINIMUM 25 FEET FROM BASEMENT FOUNDATION DRAIN

Comments Conditions SEPTIC TANK WITH RISERS & MARKER INSTALLED USING "ZABEL" FILTER

INITIAL SITE SKETCH

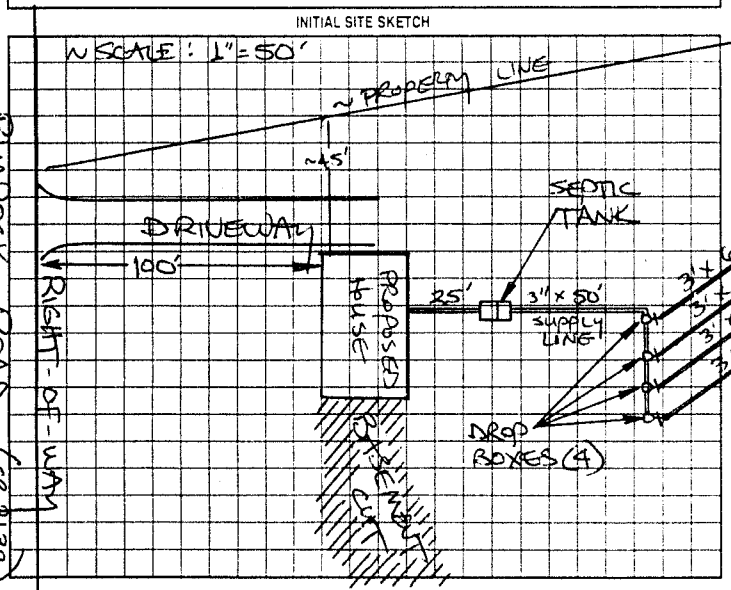

AS BUILT SKETCH

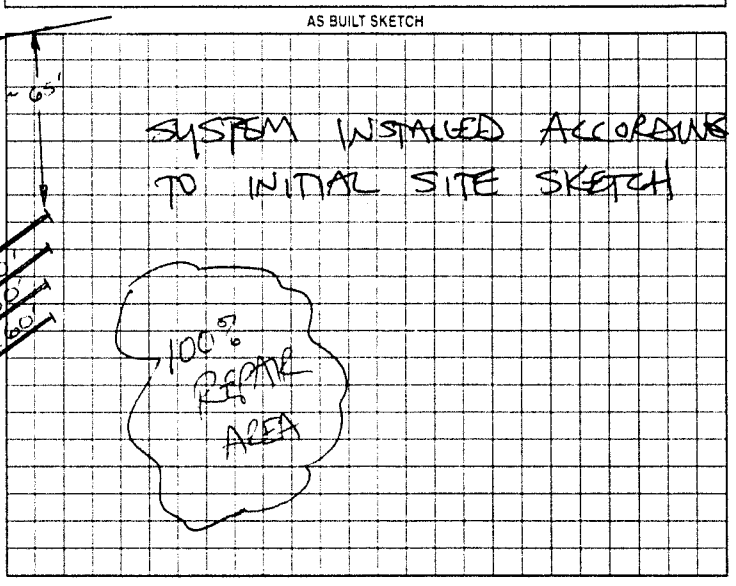

Permit can be suspended or revoked if any false information is supplied toward securing the permit any unauthorized changes are made to the site any unauthorized changes are made in the installation of the system. Improvement Permit with plat valid without expiration. Improvement Permit with site plan valid for sixty months. Authorization to Construct is valid for a period equal to that of Improvement Permit - not to exceed sixty months.

Signed: *Teresa Abee date 4-12-02 Installed by SAMMY REAVIS

Improvement Permit by: STEVE HEDRICK date 4-12-02 Operation Permit by STEVE HEDRICK date 7-3-02

Authorization to Construct by: STEVE HEDRICK date 4-12-02 Existing System Inspection by: date

HEALTH DEPT COPY WHITE OWNER COPY (FINAL) YELLOW OWNER COPY (INITIAL) PINK