IREDELL COUNTY HEALTH DEPARTMENT

STATESVILLE 704-878-5305 MOORESVILLE 704-664-5281

IMPROVEMENT PERMIT / AUTHORIZATION TO CONSTRUCT / OPERATION PERMIT / EXISTING SYSTEM INSPECTION

PERMIT# 071407 PIN# 4789 13 1261 DATE 1-22-98

OWNER OR CONTRACTOR JAMES D. GALLIHER PHONE: Business Home 539-4544

ADDRESS 3349 JENNINGS ROAD, UNION GROVE NC 28689

LOCATION 45 21 N TR MT. BETHEL RD TL RIMROCK ROAD TL SHAW ROAD, 7TH LOT ON LEFT

SUBDIVISION RIMROCK ESTATES BLOCK / SECTION LOT 8 LOT AREA 0.702 ACRE SITE CLASS PS DESIGN FLOW 480 L.T.A.R. 0.33 GPD/FT²

Septic Tank: 1000 Gallons; STB 1012 Date 10-6-97

Pump Tank: Gallons; PT Date

Pump Make: Model Serial No.

Nitrification Field: No Fields 1 Square Feet 1440 Linear Feet 480

No Lines FOUR Trench Width 36" Max Trench Bottom Depth 36" Gravel Depth 12"

☑ New System ☐ Repair System Type: I (II) III, IV, V, VI

System Description: CONVENTIONAL - GRAVITY

Repair System Description: CONV - GRAVITY

Maintenance Agreement Required: ☐ Yes ☑ No

☐ House/Mod. Home ☑ Mobile Home ☐ Business ☐ Other

No. Bedrooms 4 No. Bathrooms 2 No. Employees

☐ Slab ☑ Crawl Space ☐ Basement w/plumbing ☐ Basement wo/plumbing


Water Supply: ☐ Individual ☑ Public ☐ Community

Comments:/Conditions:


Comments:/Conditions:

SYSTEM INSTALLED JUST BEFORE PERIOD OF HEAVY RAIN

INITIAL SITE SKETCH SCALE: 1" = 50'

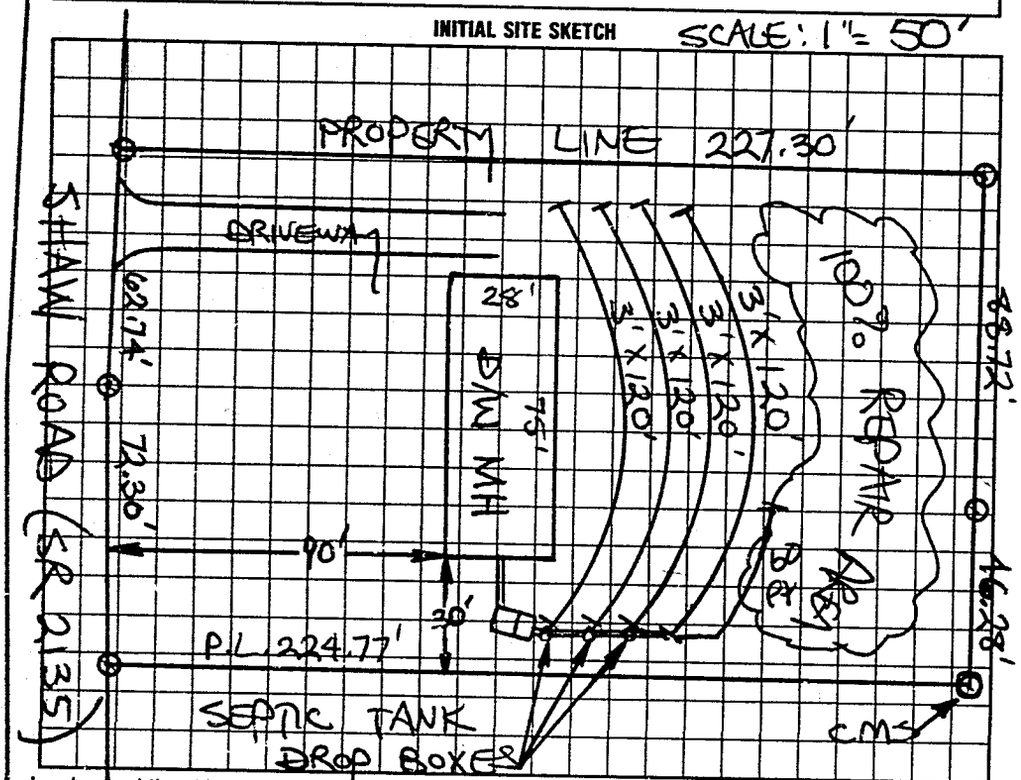

AS BUILT SKETCH

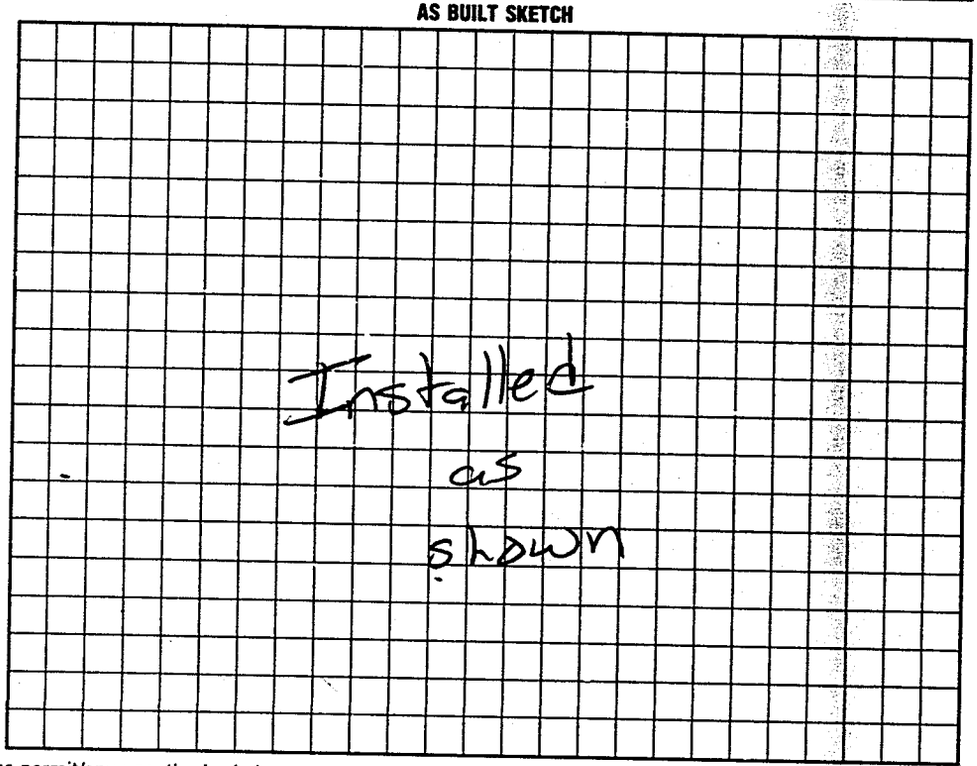

I understand that this permit can be suspended or revoked if any false information is supplied toward securing the permit/any unauthorized changes are made to the site/any unauthorized changes are made in the installation of the system. Improvement Permit with plat valid without expiration. Improvement Permit with site plan valid for sixty months. Authorization to Construct is valid for a period equal to that of Improvement Permit – not to exceed sixty months.

Signed: Dennis Dalke date 1-22-98

Improvement Permit by: STEVE HEDRICK date 1-22-98

Authorization to Construct by: STEVE HEDRICK date 1-22-98

Installed by: A-1 Backhoe

Operation Permit by: [illegible] date 2-2-98

Existing System Inspection by: [illegible] date 2-2-98

HEALTH DEPT COPY: WHITE INSPECTION COPY (FINAL) GREEN OWNER COPY (FINAL) YELLOW INSPECTION COPY (INITIAL) PINK OWNER COPY (INITIAL) GOLD