IREDELL COUNTY HEALTH DEPARTMENT

STATESVILLE 704-878-5305 MOORESVILLE 704-664-5281

IMPROVEMENT PERMIT / AUTHORIZATION TO CONSTRUCT / OPERATION PERMIT / EXISTING SYSTEM INSPECTION

PERMIT# 87771 PIN# 4789215728 DATE 2-16-00

OWNER OR CONTRACTOR Hannah Osborne PHONE: Business Home 546 2030

ADDRESS 372 Rimrock Rd Harmony N.C.

LOCATION OH Mocksville TL mt Bethel TR Rimrock TL Shaw 1/2mile RT

SUBDIVISION BLOCK / SECTION LOT LOT AREA 2.34acres SITE CLASS PS DESIGN FLOW 360 L.T.A.R. .34

Septic Tank: 1000 Gallons; STB 312 Date 10-17-99
Pump Tank: Gallons; PT Date
Pump Make: Model Serial No.
Nitrification Field: No Fields 1 Square Feet 1350 Linear Feet 350
No Lines 5 Trench Width 36" Max Trench Bottom Depth 36" Gravel Depth 12"

☐ New System ☐ Repair System Type: I, II, III, IV, V, VI
System Description: Conv. Gravity
Repair System Description:
Maintenance Agreement Required: ☐ Yes ☒ No


☐ House/Mod. Home No. Bedrooms 3
☒ Mobile Home No. Bathrooms 2
☐ Business No. Employees
☐ Other
☐ Slab ☒ Crawl Space ☐ Basement w/plumbing ☐ Basement wo/plumbing

Water Supply: ☐ Individual ☐ Public ☐ Community

R/W → To Shaw Rd


Comments/Conditions:

INITIAL SITE SKETCH

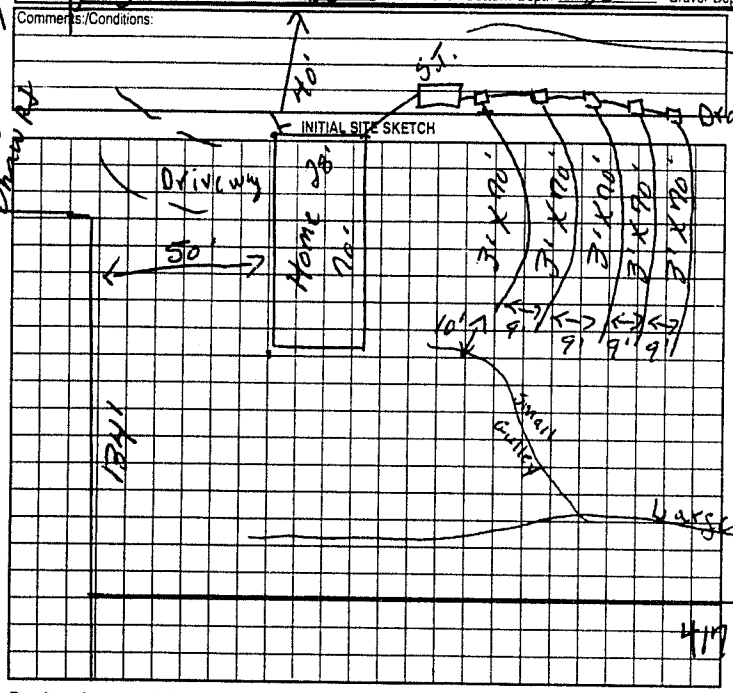

Comments/Conditions: 417' SEPTIC TANK W/ MARKER INSTALLED USING "LABEL" FILTER boxes Gullied

AS BUILT SKETCH

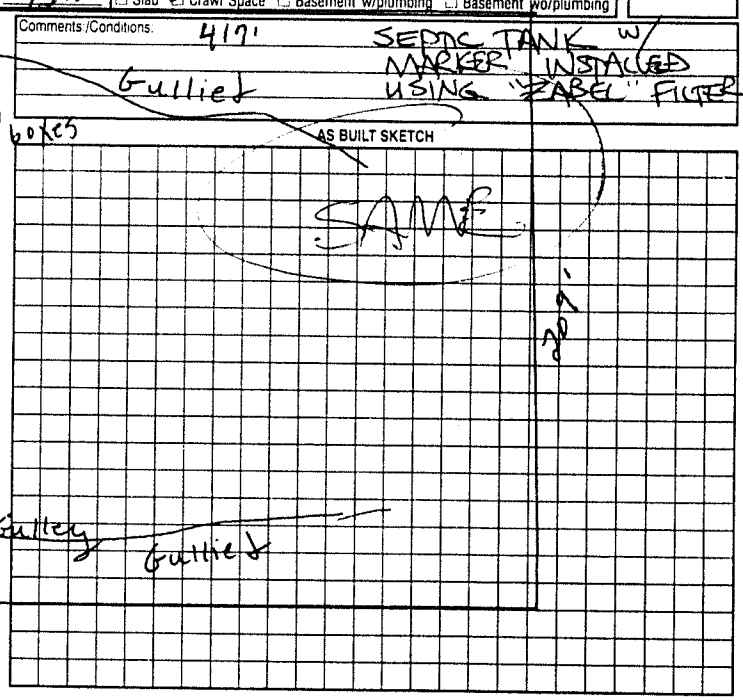

Permit can be suspended or revoked if any false information is supplied toward securing the permit/any unauthorized changes are made to the site/any unauthorized changes are made in the installation of the system. Improvement Permit with plat valid without expiration. Improvement Permit with site plan valid for sixty months. Authorization to Construct is valid for a period equal to that of Improvement Permit – not to exceed sixty months.

Signed: X. Michael Osborne date

Improvement Permit by: R. C. Moore date 2-16-00

Authorization to Construct by: R. C. Moore date 2-16-00

Installed by: GERALD TUCKER SEPTIC TANK

Operation Permit by: STEVE HENDRICK date 3-24-00

Existing System Inspection by: date

HEALTH DEPT. COPY: WHITE OWNER COPY (FINAL): YELLOW OWNER COPY (INITIAL): PINK