IREDELL COUNTY HEALTH DEPARTMENT

STATESVILLE 704-878-5305 (C1) MOORESVILLE 704-664-5281

IMPROVEMENT PERMIT / AUTHORIZATION TO CONSTRUCT / OPERATION PERMIT / EXISTING SYSTEM INSPECTION

PERMIT# 107699 PIN# 4789-14-1878 DATE 7-25-02

OWNER OR CONTRACTOR HILARY EDWARDS PHONE: Business Home 704-546-3539

ADDRESS 210 SHAW ROAD, HARMONY, NC 28634

LOCATION US 21 N, TR MT, BETHEL ROAD, TL SHAW ROAD, 1.1 MILE ON LEFT BACK OFF ROAD ~1000'

SUBDIVISION BLOCK / SECTION LOT LOT AREA 28 ACRES SITE CLASS PS DESIGN FLOW 480' L.T.A.R. 0.30 GPD/FT²

Septic Tank: 1000 Gallons: STB 1012 Date 6-30-02

Pump Tank: Gallons: PT Date

Pump Make: Model Serial No.

Nitrification Field: No Fields 1 Square Feet 1600 Linear Feet 533

No Lines FOUR Trench Width 36" Max Trench Bottom Depth 36" Gravel Depth 12"

☒ New System ☐ Repair System Type: I II III IV V VI

System Description: CONVENTIONAL GRAVITY

Repair System Description: CONVENTIONAL, GRAVITY

Maintenance Agreement Required: ☐ Yes ☒ No

☐ Slab ☒ Crawl Space ☐ Basement w/plumbing ☐ Basement wo/plumbing

☒ House/Mod. Home No. Bedrooms 4

☐ Mobile Home No. Bathrooms 2

☐ Business No. Employees

☐ Other


Water Supply: ☐ Individual ☒ Public ☐ Community

Comments:/Conditions:

Comments:/Conditions: SEPTIC TANK WITH MARKER INSTALLED USING "TUFTITE" FILTER

~SCALE: 1" = 50'

INITIAL SITE SKETCH

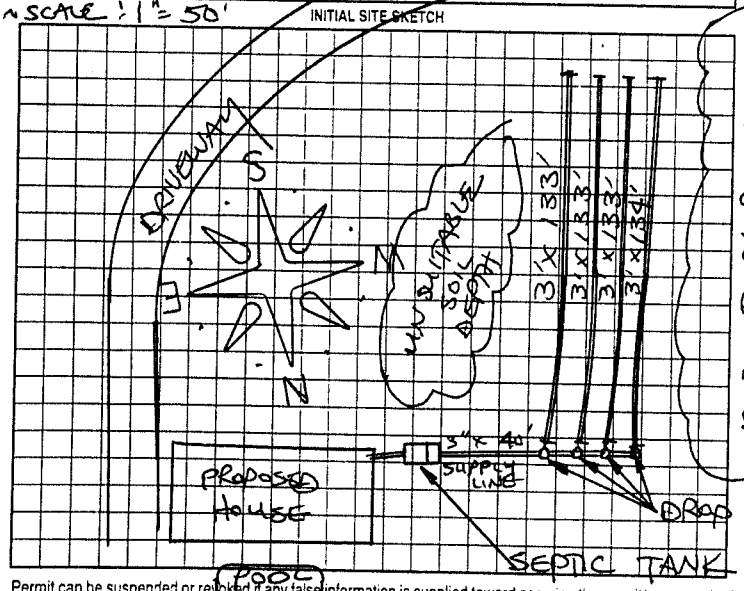

AS BUILT SKETCH

SYSTEM INSTALLED ACCORDING TO INITAL SITE SKETCH

Permit can be suspended or revoked if any false information is supplied toward securing the permit/any unauthorized changes are made to the site/any unauthorized changes are made in the installation of the system. Improvement Permit with plat valid without expiration. Improvement Permit with site plan valid for sixty months. Authorization to Construct is valid for a period equal to that of Improvement Permit – not to exceed sixty months

Signed: James E. Wilson date 7-25-02 Installed by STEVE JORDAN

Improvement Permit by: STEVE HEDRICK date 7-25-02 Operation Permit by: STEVE HEDRICK date 12-2-02

Authorization to Construct by: STEVE HEDRICK date 7-25-02 Existing System Inspection by: date

HEALTH DEPT. COPY: WHITE OWNER COPY (FINAL): YELLOW OWNER COPY (INITIAL): PINK