IREDELL COUNTY HEALTH DEPARTMENT - *ENVIRONMENTAL HEALTH* ☐ STATESVILLE OFFICE 704-878-5305 ☐ MOORESVILLE OFFICE 704-664-5281

IMPROVEMENT PERMIT / AUTHORIZATION TO CONSTRUCT / OPERATION PERMIT / EXISTING SYSTEM INSPECTION

PERMIT # 167045 PIN # 4789-38-2359 DATE 7 July 2011

OWNER Richard Smith APPLICANT: PHONE: Home/Cell # (336) 455-1375 Business #

SITE ADDRESS 321 Kinder Rd. Harmony OWNER / APPLICANT ADDRESS

SITE DIRECTIONS Hwy 21N TR Memorial Hwy TR Kinder Rd. on Rt.

SUBDIVISION BLOCK / SECTION LOT # LOT AREA 7.5 Ac. DESIGN FLOW 360 gpd L.T.A.R. 0.3 gpd/ft²

Septic Tank 1000 Gallons: STB 760 Date 4-24
Pump Tank Gallons: P T Date
Pump Make Model Serial #
No. Nitrification Fields: 1 No. Lines 4 Linear Feet 400
Trench Width 36" Max. Trench Bottom Depth 36" Gravel Depth 12"

☑ New System ☐ Repair ☐ Expansion System Type I (II) III IV V VI
System Description: Conventional / gravel trench
Repair System Description: Conventional / trench
Maintenance Agreement Required ☐ YES ☑ NO
☑ GRAVITY ☐ PRESSURE


☑ Residence No. Bedrooms 3
☐ Business No. Persons
☐ Other No. Employees
☐ Slab ☑ Crawl Space
☐ Basement w/plumbing ☐ Basement w/o plumbing

Water Supply: ☑ Private ☐ Public ☐ Community

Comments / Conditions * May be installed as an Accepted system.
* Keep system 100' from well.

Poly loc filter

INITIAL SITE SKETCH

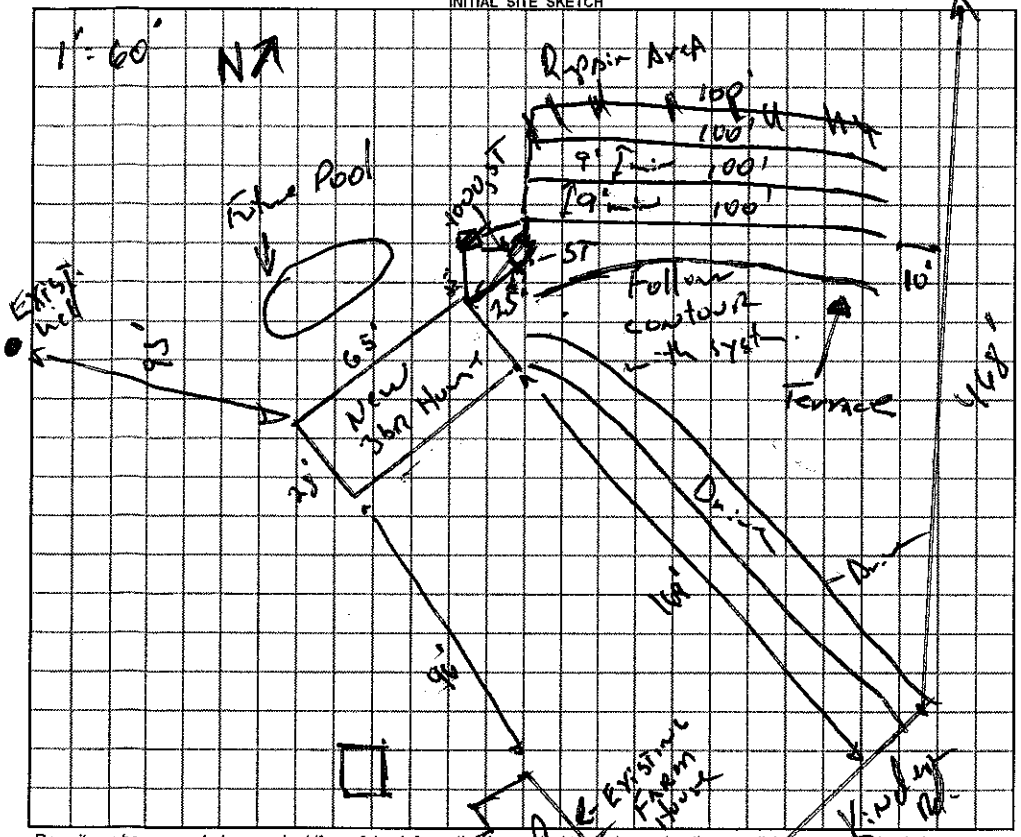

AS BUILT SKETCH

Installed as Fut. Quote- 4

Installed as 3 lines x 100'

Permit can be suspended or revoked if any false information is supplied toward securing the permit / any unauthorized changes are made to the site / any unauthorized changes are made in the installation of the system.

☐ *IMPROVEMENT PERMIT with plat valid without expiration.* ☑ *IMPROVEMENT PERMIT with ~~plat valid without expiration.~~ site plan valid 60 mo.* ☑ *AUTHORIZATION TO CONSTRUCT* valid for period equal to IMPROVEMENT PERMIT--not to exceed 60 mo.

Owner / Applicant Signature: Date 7-8-11 Installed by: A-1 Backhoe

IMPROVEMENT PERMIT by: REHS Date 7-14-11 OPERATION PERMIT by: REHS Date 22 Aug 11

AUTHORIZATION TO CONSTRUCT by: REHS Date 7-14-11 Existing System Inspected by: REHS Date

YOU SHOULD CONTACT A LOCATOR SERVICE PRIOR TO ANY EXCAVATION

White Copy – Environmental Health YELLOW COPY (Final) Owner / Applicant PINK COPY (Initial) Owner / Applicant