IREDELL COUNTY HEALTH DEPARTMENT

STATESVILLE 704-878-5305 MOORESVILLE 704-664-5281

IMPROVEMENT PERMIT / AUTHORIZATION TO CONSTRUCT / OPERATION PERMIT / EXISTING SYSTEM INSPECTION

DATE 1-15-08

PERMIT# 149573 PIN# 4738494552 1588

OWNER OR APPLICANT Maurice Mosher PHONE: Business 704-202-5423 Home

ADDRESS 310 Country Ridge Road ROCKWELL NC 28138

LOCATION 21W (R) 901 (R) Kirkin RD - 401 Lynda RD

SUBDIVISION Spring Hill BLOCK / SECTION I LOT 54 LOT AREA 1.50 SITE CLASS. B DESIGN FLOW 240 L.T.A.R. 3

Septic Tank: 1000 Gallons: STB 160 Date 8-15-07

Pump Tank: Gallons: PT Date

Pump Make: Model Serial No.

Nitrification Field: No Fields Square Feet 800 Linear Feet 200

No Lines 2 Trench Width 36 Max Trench Bottom Depth 36

☑ New System ☐ Repair ☐ Expansion System Type: I (II) III IV V VI

System Description: 250 Gallons

Repair System Description: 250 Gallons

Maintenance Agreement Required: ☐ Yes ☑ No

Gravel Depth NE ☑ Gravity ☐ Pressure

☑ House/Mod. Home ☐ Mobile Home ☐ Business ☐ Other

No. Bedrooms 2 No. Persons No. Employees

Water Supply: ☑ Individual ☐ Public ☐ Community

☐ Slab ☐ Crawl Space ☐ Basement w/plumbing ☐ Basement wo/plumbing


Comments:/Conditions:

* NOT to SCALE


Comments:/Conditions:

* 30 inches under Drive with supply line

INITIAL SITE SKETCH

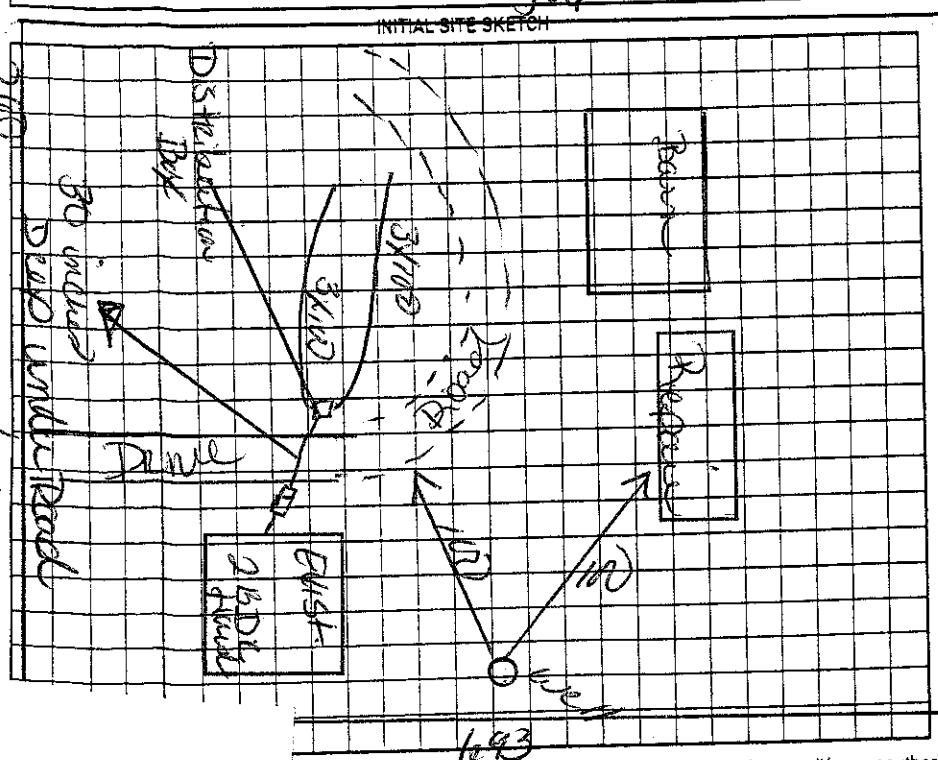

AS BUILT SKETCH

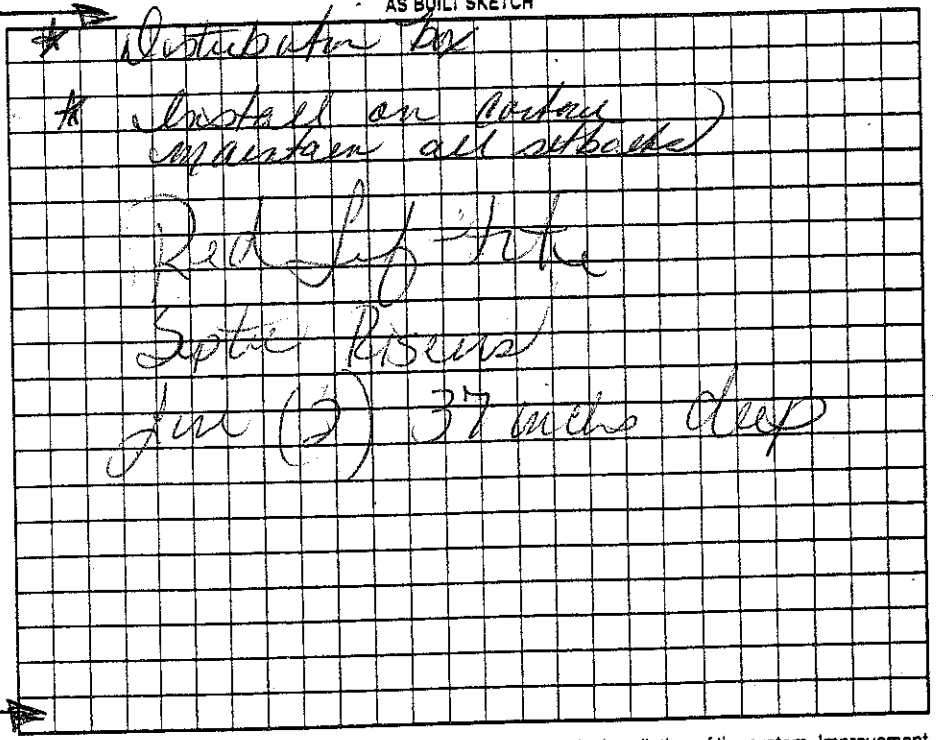

Hooked if any false information is supplied toward securing the permit/any unauthorized changes are made to the site/any unauthorized changes are made in the installation of the system. Improvement Permit Expiration ☐ Improvement Permit with site plan valid for sixty months ☑ Authorization to Construct is valid for a period equal to that of Improvement Permit – not to exceed sixty months.

Installed by: Tommy Dewar date 1-15-8

Operation Permit by: Kelly Cook date 1-15-08

Existing System Inspection by: Kelly Cook date 1-15-08

Operation Permit by: Kelly Cook date 1-22-08

Existing System Inspection by: date

HEALTH DEPT. COPY: WHITE OWNER COPY (FINAL): YELLOW OWNER COPY (INITIAL): PINK