IREDELL COUNTY HEALTH DEPARTMENT

STATESVILLE 704-878-5305 MOORESVILLE 704-664-5281

IMPROVEMENT PERMIT / AUTHORIZATION TO CONSTRUCT / OPERATION PERMIT / EXISTING SYSTEM INSPECTION

80x40'

PERMIT# 115743 PIN# ~~4784-49-2445.000~~ 4789-49-3256 DATE 10-1-03

OWNER OR CONTRACTOR MARVIN MOSHER PHONE: Business 704-202-5473 Home

ADDRESS 310 COUNTRY RIDGE RD ROCKWELL N.C. 28138

LOCATION 21 NORTH, (R) 901, (R) KINDER RD, (R) ≈ 1/8 mile on RT AT LOT # 6

SUBDIVISION SPRING HILLS BLOCK / SECTION LOT 6 LOT AREA .645 AC SITE CLASS. PS DESIGN FLOW 360 L.T.A.R. .3

Septic Tank: 1000 Gallons; STB 1012 Date 6-5-06

Pump Tank: Gallons; PT Date

Pump Make: Model Serial No. 3001

Nitrification Field: No Fields 1 Square Feet 1200' Linear Feet ~~400'~~

No Lines Trench Width 36" Max Trench Bottom Depth 36" Gravel Depth 12"

☒ New System ☐ Repair System Type: I, (II), III, IV, V, VI

System Description: CONV GRAV 25% BENEFIT

Repair System Description: LP PANEL

Maintenance Agreement Required: ☐ Yes ☒ No

☒ House/Mod. Home No. Bedrooms 3½

☐ Mobile Home No. Bathrooms

☐ Business No. Employees

☐ Other

☐ Slab ☒ Crawl Space ☐ Basement w/plumbing ☐ Basement wo/plumbing


Water Supply: ☒ Individual ☐ Public ☐ Community

Comments:/Conditions: (1) INSTALL LINES ON CONTOURS (2) MAINTAIN SETBACKS (3) SYSTEM & HOUSE IS FLAGGED OUT (4) KEEP END OF LINES 15' OFF TOP OF EMBANKMENT CUT, "AS FLAGGED"


Comments:/Conditions: LC APPROVED 83'X38' HOUSE PLAN. 24'x24' GARAGE MUST BE 33' OFF SIDE P/L INSTEAD OF 57'. THIS WILL KEEP THE STUBOUT IN THE SAME LOCATION. THE 49' SETBACK WILL NOW BE 62' & THE TWO FRONT SETBACKS AS BUILT SKETCH OF 66' & 67' WILL REMAIN THE SAME, THE EXTRA WIDTH OF 10' WILL BE ADDED TO THE BACK OF THE HOUSE & ENCROACH EVEN MORE INTO THE WELL SETBACK.

1" ≈ 50'

INITIAL SITE SKETCH

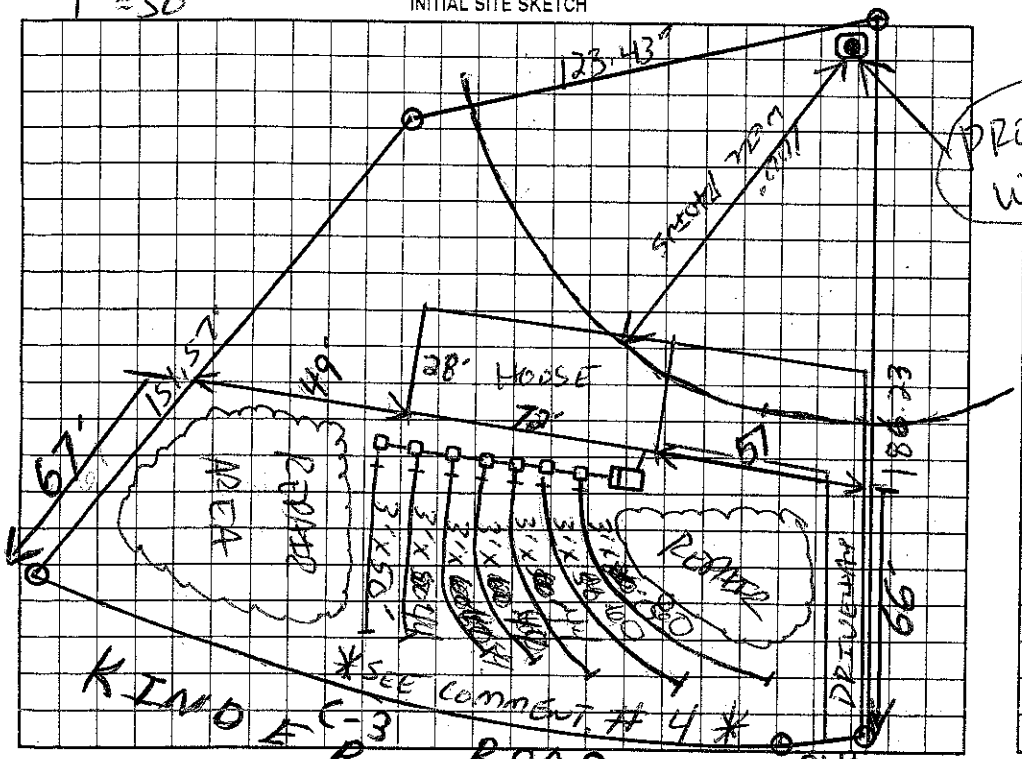

"NOT TO SCALE" APPROVED CHANGES

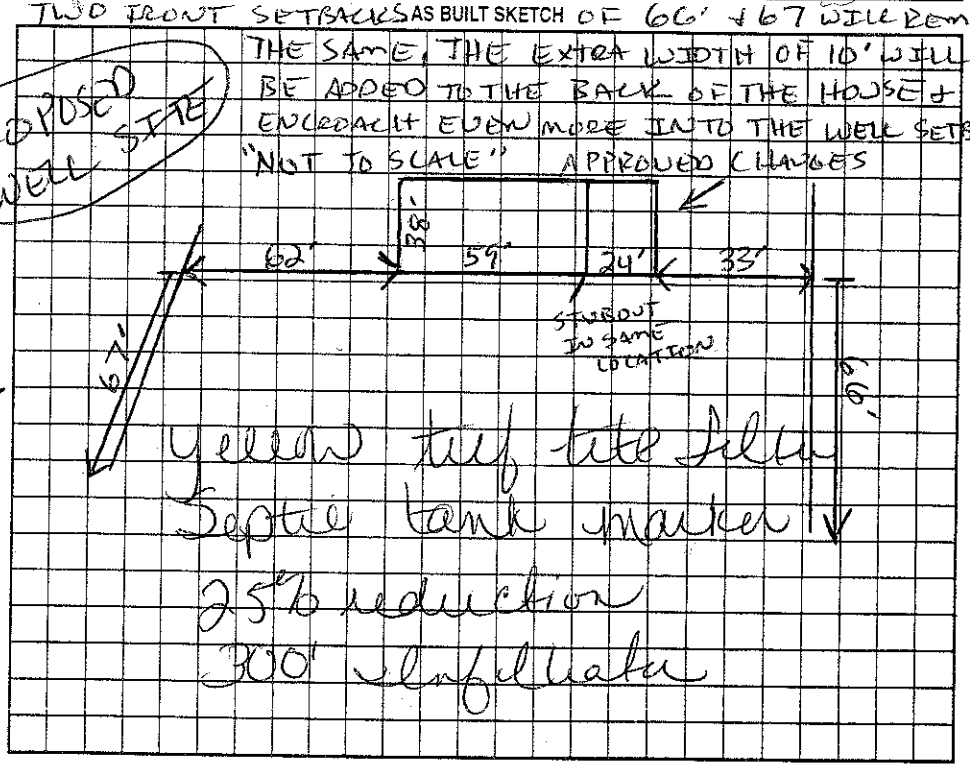

Permit can be suspended or revoked if any false information is supplied toward securing the permit/any unauthorized changes are made to the site/any unauthorized changes are made in the installation of the system. Improvement Permit with plat valid without expiration. Improvement Permit with site plan valid for sixty months. Authorization to Construct is valid for a period equal to that of Improvement Permit – not to exceed sixty months.

Signed: Marvin K Mosher date 10-8-03

Improvement Permit by: PS date 10-1-03

Authorization to Construct by: PS date 10-1-03

Installed by: Mark Wingler

Operation Permit by: PS date 11-13-06

Existing System Inspection by: date

HEALTH DEPT. COPY: WHITE OWNER COPY (FINAL): YELLOW OWNER COPY (INITIAL): PINK