IREDELL COUNTY HEALTH DEPARTMENT

STATESVILLE 704-878-5305 MOORESVILLE 704-664-5281

IMPROVEMENT PERMIT / AUTHORIZATION TO CONSTRUCT / OPERATION PERMIT / EXISTING SYSTEM INSPECTION

PERMIT# REPAIR PIN# 4789-51-5114 DATE 5-31-07

OWNER OR APPLICANT CLARENCE L. STROUD PHONE: Business _____ Home 704-546-7856

ADDRESS 254 CARTNER ROAD, STATESVILLE, NC 28625

LOCATION OLD MOCKSVILLE ROAD, TL CARTNER ROAD, ON RIGHT AT # 254

SUBDIVISION _____ BLOCK / SECTION _____ LOT _____ LOT AREA 3.55 ACRES SITE CLASS. PS DESIGN FLOW 240 L.T.A.R. 0.30 GPD/FT²

Septic Tank: EXISTING Gallons: STB _____ Date _____

Pump Tank: _____ Gallons: PT _____ Date _____

Pump Make: _____ Model _____ Serial No. _____

Nitrification Field: No Fields 1 Square Feet 800 Linear Feet 200

No Lines THREE Trench Width 36" Max Trench Bottom Depth 36"

☑ New System ☑ Repair ☐ Expansion System Type: I II III IV V VI

System Description: _____

Repair System Description: 25% REDUCTION, GRAVITY

Maintenance Agreement Required: ☐ Yes ☑ No

Gravel Depth N/A ☑ Gravity ☐ Pressure

☑ House/Mod. Home No. Bedrooms 2

☐ Mobile Home No. Persons ____

☐ Business No. Employees ____

☐ Other _____


Water Supply: ☐ Individual ☐ Public ☐ Community WELL

☐ Slab ☐ Crawl Space ☐ Basement w/plumbing ☐ Basement wo/plumbing


Comments:/Conditions: INSTALL 25% REDUCTION SYSTEM ON CONTOUR (CROSS EXISTING LINES IF NECESSARY)

Comments:/Conditions: SYSTEM REPAIRED ACCORDING TO INITAL SITE SKETCH

INITIAL SITE SKETCH

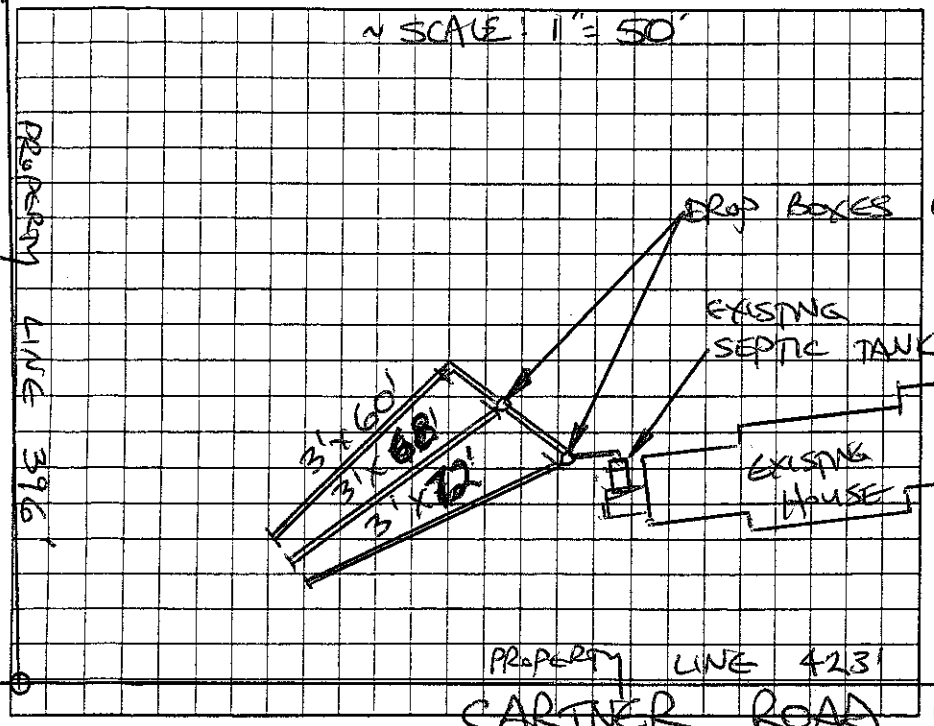

AS BUILT SKETCH

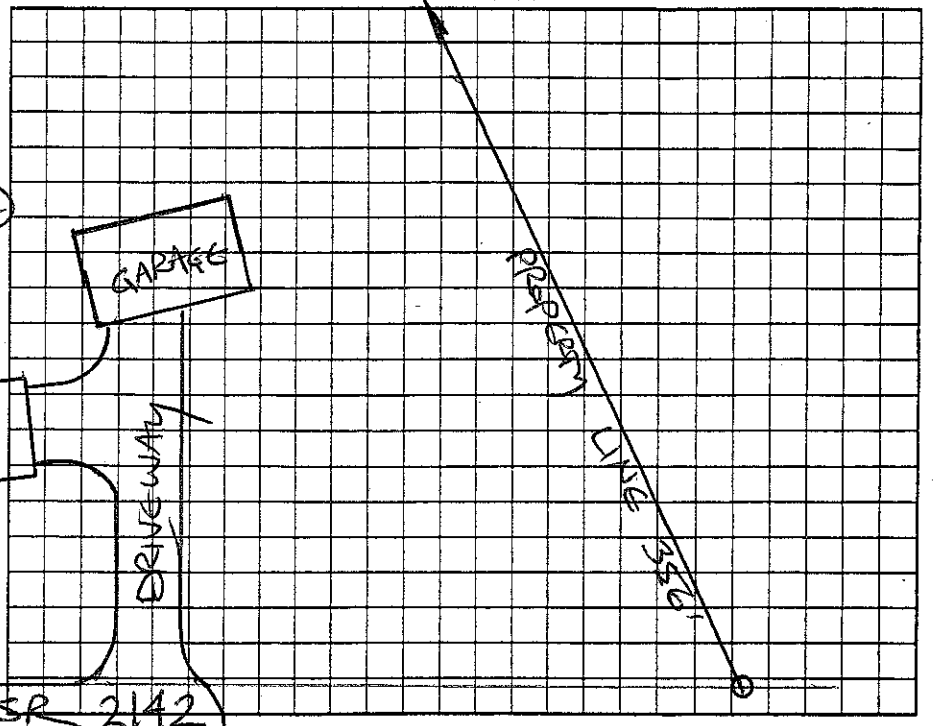

Permit can be suspended or revoked if any false information is supplied toward securing the permit/any unauthorized changes are made to the site/any unauthorized changes are made in the installation of the system. Improvement Permit with plat valid without expiration ☐ Improvement Permit with site plan valid for sixty months ☑ Authorization to Construct is valid for a period equal to that of Improvement Permit – not to exceed sixty months.

Signed Clarence L Stroud date 5-31-07 Installed by: ABEE'S GRADING

Improvement Permit by: STEVE HENDRICK date 5-31-07 Operation Permit by: STEVE HENDRICK date 6-13-07

Authorization to Construct by: STEVE HENDRICK date 5-31-07 Existing System Inspection by: _____ date _____

HEALTH DEPT. COPY: WHITE OWNER COPY (FINAL): YELLOW OWNER COPY (INITIAL): PINK